

15-171-60001-00-50

STATE OF KANSAS  
STATE CORPORATION COMMISSION


WELL PLUGGING RECORD

OR  
FORMATION PLUGGING RECORD

Give all information completely  
Make Required Affidavit  
Fill or Deliver Report to:  
Conservation Division  
State Corporation Commission  
300 Bittling Building  
Wichita, Kansas

Strike out upper line  
when reporting plug-  
ging off formations.

NORTH

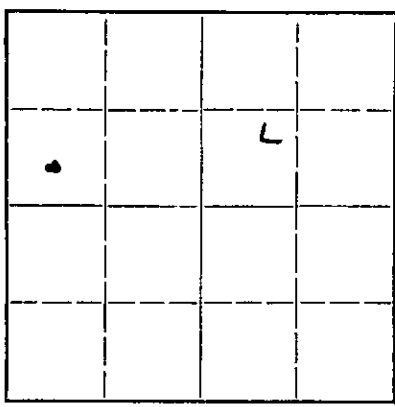

Locate well correctly on above  
Section Plat

Scott County. Sec. 14. Twp. 20S Rge. 33W (E) (W)  
Location as "NE 1/4 NW 1/4 SW 1/4" or footage from lines.....  
Lease Owner. Shallow Water Refining Company  
Lease Name. Harvey Dague Well No. 1  
Office Address 114 West Pine St. Garden City, Kansas  
Character of Well (completed as Oil, Gas or Dry Hole)..... Oil Well  
Date well completed..... 9-11- 19. 37  
Application for plugging filed..... 7-2- 19. 47  
Application for plugging approved..... 7-3- 19. 47  
Plugging commenced..... 7-20- 19. 47  
Plugging completed..... 7-28- 19. 47  
Reason for abandonment of well or producing formation..... Poor production

If a producing well is abandoned, date of last production..... 7-7- 19. 47  
Was permission obtained from the Conservation Division or its agents before plugging was com-  
menced?..... Yes

Name of Conservation Agent who supervised plugging of this well..... Herb Kerr Great Bend, Kansas  
Producing formation..... Mississippi Depth to top..... 4620 Bottom..... 4680 Total Depth of Well..... 4680 Feet  
Show depth and thickness of all water, oil and gas formations.

OIL, GAS OR WATER RECORDS

CASING RECORD

Formation	Content	From	To	Size	Put In	Pulled Out
Mississippi	Crude oil	4620'	4680'	7" - 24#	4622'	1629' - 2"
				15 1/2" S.C.	240'	None

Describe in detail the manner in which the well was plugged, indicating where the mud fluid was placed and the method or methods used in introducing it into the hold. If cement or other plugs were used, state the character of same and depth placed, from..... feet to..... feet for each plug set.

Filled to 4620' with sand, dumped 5 sax of cement, filled with mud and 30 sax of cement to 240' mud close to top, 10 sax cement on top for cap.

(If additional description is necessary, use BACK of this sheet)

Correspondence regarding this well should be addressed to..... Shallow Water Refining Company  
Address..... 114 West Pine St. Garden City, Kansas

STATE OF Kansas, COUNTY OF Scott, ss.  
..... (employee of owner) or (owner or operator) of the above-described well,  
being first duly sworn on oath, says: That I have knowledge of the facts, statements, and matters herein contained and the log of the above-described well as filed and that the same are true and correct. So help me God.

(Signature)..... [Signature]  
(Address).....

SUBSCRIBED AND SWORN to before me this 1 day of Aug, 1949  
[Signature] Notary Public.

My commission expires..... July 1 1949  
21-6858-RS 2-47-6M

PLUGGING  
FILE SEC 14 T 20 R 33W  
BOOK PAGE 118 LINE 4

# WELL RECORD

15-171-60001-00-00

Block or Twp. Sec.14-20 S. 33 W.

Lease <sup>H</sup>arvey E. Dague  
Lease No. Ks.5103  
County Scott

Well No. 1

Location Cen.SW.NW.Sec.14-20S-33W.

State Kansas

Elevation 2934 Feet

Drilled { Contract  
Company Tools

Contracted Depth  
Completed Depth

Feet Date { Started <sup>May.6,1935</sup>  
Completed *Aug 14-1935*  
Deepened  
Cleaned Out

Name of Contractor

Contract Price Per Foot

Day Work

Well Estimated Cost  
Well Actual Cost

Method of Drilling

BEFORE SHOOTING

Initial Production <sup>1000</sup> *400* Flowing  
Settled Production on Pump

Initial Production *600* Flowing  
Settled Production on Pump

Baume Test *20* Water With Oil %

Casing Record

Torpedo Record

SIZE	SET	PULLED	Date	Company	From	To	Feet	Size of Shell	Total Qts.
15 1/2"	240'	250 Sacks Cement	<i>4/2/35</i>						
"	4622	300 " "			<i>4637</i>		<i>4644</i>		<i>3.0</i>

Cellar	0	12'	Chalk	3435-3443
Clay	12	240'	Lime	3443-3465
Soft Chalk	240	300	Shale	3465-3474
Shale	300	560	Slate & Sand Shells	3474-3480
Broken Lime	560	595	White Lime	3480-3521
Shale & Shells	595	813	Shale	3521-3545
Sand & Shale	813	910	Lime	3545-3624
Blue Shale	910	995	Blue Chert	3624-3627
Sand & Shale	995	1205	Lime	3627-3693
Red Rock & Shale	1205-1355		Lime & Red Rock	3693 3731
Red Rock & Lime	1355-1510		Lime & Shale	3731-3923
Red Bed & Sand	1510-1760		Gray Lime	3923-3957
Shale & Shells	1760-1870		Lime & Red Bed	3957-3988
Gypsum & Red Bed	1870-1920		Gray Lime	3988-4265
Red Bed & Shale	1920-2090		Lime & Red Rock	4265-4300
Sand & Red Rock	2090-2165		Gray Lime	4300-4368
Shale & Broken Lime	2165-2190		Sand & Lime	4368-4390
Shale	2190-2245		Gray Lime	4390-4393
Shale & Shells	2245-2310		Lime & Shale	4393-4431
Broken Lime	2310-2345		Lime & Chert	4431-4443
Sand & Red Shale	2345-2488		Lime & Shale	4443-4455
Broken Lime	2485-2531		Hard Lime	4455-4473
Shale	2531-2555		Shale & Lime	4473-4492
Sand & Shale	2555-2630		Shale & Shells	4492-4517
Shale & Lime	2630-2716		Lime	4517-4570
Sand & Shale	2716-2800		Sticky Shale, with	
Shale & Lime	2800-2985		ard Sand & Lime Shells	4570-4590
Broken Lime	2985-3060		Shale & Lime	4590-4636
Sand & Shale	3060-3103		Sand & Lime	4636-4641
Lime & Shale	3103-3206		Lime	4641-4646
Shale & sand	3206-3300			
Shale	3300-3305			
Sandy Lime	3305-3318			
Broken Lime	3318-3340			
Shale	3340-3380			
Lime & Shells	3380-3393			
Broken Lime & & Chert	3393-3435			

**PLUGGING**  
FILE REC 14 T 20 R 33W  
BOOK PAGE 118 LINE 4