

15-171-19054-00-00


Give All Information Completely
Make Required Affidavit
Mail or Deliver Report to:
Conservation Division
State Corporation Commission
800 Bitting Building
Wichita, Kansas

OR

FORMATION PLUGGING RECORD

Strike out upper line
when reporting plugging
off formations.

NORTH

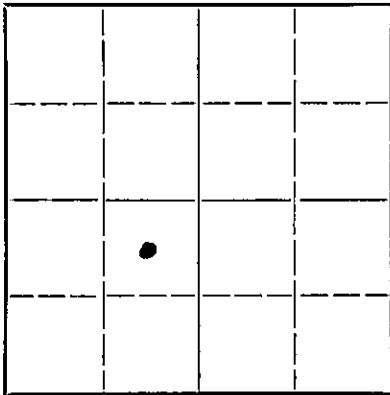

Locate well correctly on above
Section Plat

Scott County. Sec. 14 Twp. 20 Rge. (E) 33 (W)
Location as "NE $\frac{1}{4}$ NW $\frac{1}{4}$ SW $\frac{1}{4}$ " or footage from lines. C NE $\frac{1}{4}$ SW $\frac{1}{4}$
Lease Owner. The Shallow Water Refining Company
Lease Name. File Well No. 1
Office Address. 114 West Pine St., Garden City, Kansas
Character of Well (completed as Oil, Gas or Dry Hole). Oil
Date well completed. July 28, 1937
Application for plugging filed. March 30, 1951
Application for plugging approved. March 31, 1951
Plugging commenced. April 19, 1951
Plugging completed. May 27, 1951
Reason for abandonment of well or producing formation. No longer commercially
productive
If a producing well is abandoned, date of last production. April 1949
Was permission obtained from the Conservation Division or its agents before plugging was commenced? Yes

Name of Conservation Agent who supervised plugging of this well. Eldon Petty
Producing formation. Mississippi Depth to top. 4635' Bottom. 4653' Total Depth of Well. 4653 Feet
Show depth and thickness of all water, oil and gas formations.

OIL, GAS OR WATER RECORDS

CASING RECORD

Formation	Content	From	To	Size	Put In	Pulled Out
Mississippi	Lime	4635	-	7"	4635'	1631'

Describe in detail the manner in which the well was plugged, indicating where the mud fluid was placed and the method or methods used in introducing it into the hole. If cement or other plugs were used, state the character of same and depth placed, from _____ feet to _____ feet for each plug set.

No plug. Perforated to 4257'
Filled with gravel from 4653' to 4630'.
Dumped 5 sacks cement.
Filled with gravel from 4620' to 4250'.
Dumped 5 sacks cement.
Mudded hole to 220'.
Ran 25 sacks cement.
Mudded to 20'.
Dumped 10 sacks cement.

RECEIVED
STATE CORPORATION COMMISSION
JUN - 5 1951
CONSERVATION DIVISION
Wichita, Kansas

(If additional description is necessary, use BACK of this sheet)

Correspondence regarding this well should be addressed to. The Shallow Water Refining Company
Address. 114 West Pine St.
Garden City, Kansas

STATE OF Kansas, COUNTY OF Finney, ss.
Ben L. Kelley (employee of owner)

being first duly sworn on oath, says: That I have knowledge of the facts, statements, and matters herein contained and the log of the above-described well as filed and that the same are true and correct. So help me God.

(Signature) Ben L. Kelley
Garden City, Kansas (Address)

SUBSCRIBED AND SWORN to before me this 4th day of June, 1951

Catherine Petersen
Notary Public.

My commission expires June 1, 1953

PLUGGING
FILE SEC 14 T 20 R 33 W
BOOK PAGE 70 LINE 37

15-171-19054-00-00

W E L L L O G

File No. 1

C NE $\frac{1}{4}$ SW $\frac{1}{4}$ Section 14-20S-33W, Scott County, Kansas

Commenced: 6-19-37

Elevation: 2944'

Completed: 7-28-37

Contractor: Reading & Bates

13 3/8" surface casing set at 249'.

7" casing set at 4635'.

<u>Formation</u>	<u>From</u>	<u>To</u>
Surface clay	0	20
Shale	20	65
Sand	65	80
Shale	80	120
Sand	120	180
Lime	180	200
Shale & shells	200	885
Lime	885	905
Shale	905	1110
Lime	1110	1130
Shale	1130	1230
Red bed & shells	1230	1300
Lime & shale	1300	1335
Shale & shells	1335	1410
Redbed, shale & shells	1410	1425
Shale & shells	1425	1440
Lime	1440	1460
Redbed & shale	1460	1515
Shale & lime	1515	1545
Redbed & shale	1545	1590
Redbed	1590	1605
Shale & salt	1605	1890
Shale & shells	1890	2035
Redbed & shale	2035	2090
Lime	2090	2115
Shale & redbed	2115	2180
Lime & shale	2180	2215
Redbed, shale & shells	2215	2260
Shale & lime	2260	2295
Broken lime & shale	2295	2500
Lime & shale	2500	2980
Shale & lime shells	2980	3035
Lime & shale	3035	3280
Shale & shells	3280	3385
Shale & lime	3385	3925
Broken lime	3925	4110
Lime	4110	4521
Lime & shale	4521	4575
Lime	4575	4653
Total Depth		4653

State of Kansas)
County of Finney) SS

I hereby certify that the above Well Log is true and correct, to the best of my knowledge and belief.

WELLS SEC. 14-20 R 33W
BOOK PAGE 70 LINE 37

Ben L. Kelley

Subscribed and sworn to before me this 30 day of March, 1951

My commission expires June 1, 1953.

Catherine Petersen