

15-173-00141-0000  
WELL PLUGGING RECORD

**Give All Information Completely**  
**Make Required Affidavit**  
**Mail or Deliver Report to:**  
**Conservation Division**  
**State Corporation Commission**  
**800 Bittling Building**  
**Wichita, Kansas**

**OR**

Strike out upper line  
when reporting plug-  
ging off formations.

## FORMATION PLUGGING RECORD

NORTH


Locate well correctly on above  
Section Plat

Sedgwick County. Sec. 25 Twp. 25 Rge. (E) 2 (W)  
Location as "NE¼NW¼SW¼" or footage from lines. SW SW SW  
Lease Owner. C. L. Carlock  
Lease Name. Basore Well No. #1  
Office Address. Oklahoma City, Oklahoma  
Character of Well (completed as Oil, Gas or Dry Hole) Dry  
Date well completed. January 1 1949  
Application for plugging filed. January 4 1949  
Application for plugging approved. January 5 1949  
Plugging commenced. January 1 1949  
Plugging completed. January 1 1949  
Reason for abandonment of well or producing formation. Dry  
If a producing well is abandoned, date of last production. 19  
Was permission obtained from the Conservation Division or its agents before plugging was commenced? Yes

Name of Conservation Agent who supervised plugging of this well..... D. C. Lilley.....  
Producing formation..... Depth to top..... Bottom..... Total Depth of Well..... 4090 Feet  
Show depth and thickness of all water, oil and gas formations.

## OIL, GAS OR WATER RECORDS

## CASING RECORD

[illegible]

Describe in detail the manner in which the well was plugged, indicating where the mud fluid was placed and the method or methods used in introducing it into the hole. If cement or other plugs were used, state the character of same and depth placed, from.....feet to .....feet for each plug set.

Filled with mud to 245', set plug cemented with 15 sacks Monarch cement, filled with mud to 5' five sacks cement on top.

(If additional description is necessary, use BACK of this sheet)

Correspondence regarding this well should be addressed to.....  
Address.....

STATE OF Kansas, COUNTY OF Sedgewick, ss.  
Charles Carlock (employee of owner) or (owner or operator) of the above-described well,  
 being first duly sworn on oath, says: That I have knowledge of the facts, statements, and matters herein contained and the log of the above-described well as filed and that the same are true and correct. So help me God.


(Signature)

.....  
(Address)

SUBSCRIBED AND SWORN to before me this 10 day of January, 19 40

My commission expires June 11, 1952

*Notary Public.*

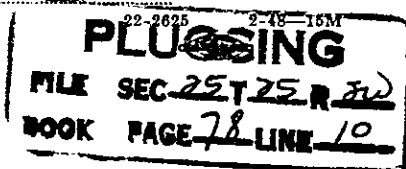

BASE

Location: SW SW SW  
Sec. 25-25S-2W  
Sedgwick County, Kansas

Commenced - Dec. 15, 1948

Completed - Jan. 1, 1949

Operator: C. L. Carlock

Rotary Drilling

Contractor: Shawver-Graham, Inc.

Casing Record: Run 345' of 8 5/8" casing  
to bottom,WELL LOG

(Figures indicate bottom of formation)

Surface sand	0' - 40'	Lime & Shale	2734'
Clay	120'	Shale & Lime	2805'
Shale & Shells	140'	Lime	2865'
Shale	190'	Lime	2899'
Shells	190'	Lime	2932'
Lime	245'	Lime	2955'
Shale & Shells	390'	Shale Lime	2985'
Lime Shale	460'	Shale	3050'
Lime & Shale	540'	Shale	3130'
Lime	560'	Shale	3200'
Shale	660'	Shale Lime	3270'
Shale & Shells	675'	Shale	3378'
Lime & Shale	850'	Shale	3494'
Shale & Lime	995'	Lime	3605'
Shale & Lime	1230'	Chert	3635'
Shale & Shells	1435'	Lime Shale	3665'
Shale & Shells	1675'	Lime	3510'
Shale & Shells	1770'	Chert Lime	3560'
Shale & Lime	1800'	Lime and chert and shale	3605'
Shells & Shale	1925'	Lime	3632'
Shale & Shells	1945'	Lime	3677'
Lime	1980'	Shale	3685'
Shale & Lime	2075'	Shale	3715'
Lime	2125'	Lime and Shale	3772'
Lime	2210'	Lime	3805'
Lime & Shale	2370'	Shale & Lime	3870'
Shale & Shells	2540'	Lime	3886'
Lime Sand	2622'	Lime	3905'
Sandy Lime	2635'	Lime	3940'
Lime	2700'	Shale & Lime	3965'
		Lime-Sandy	3994'
		Chert & Lime	4026'
		Lime	4054'
		Lime & T. D.	4090'

The undersigned, Shawver-Graham, Inc., hereby certifies that the above log is a true and correct log of the formation encountered in drilling the above noted well as reflected by the Daily Drilling Reports.

**PLUGGING**

FILE SEC 25 T 25 R 2W  
BOOK PAGE 78 LINE 10

State of Kansas  
County of Sedgwick

SHAWVER-GRAHAM, INC.

By: D. M. Shawver  
President

Be it remembered that on this 6th day of January, 1949, before me the undersigned, a notary public, duly commissioned in and for the County and State aforesaid, came D. M. Shawver, President of SHAWVER-GRAHAM, INC., a Corporation of the State of Kansas, personally known to me to be such officer, and to be the same person who executed as such officer the foregoing instrument of writing in behalf of said Corporation, and he duly acknowledged the execution of the same for himself and for said Corporation.

IN WITNESS WHEREOF, I have hereunto set my hand and official seal on the day and year last above written.

My commission expires: June 1, 1952

**PLUGGING**  
FILE SEC 25 T 25 R 2W  
BOOK PAGE 78 LINE 10

Martha M. Camden  
Notary Public