


STATE OF KANSAS
STATE CORPORATION COMMISSION

Give All Information Completely
Make Required Affidavit
Mail or Deliver Report to:
Conservation Division
State Corporation Commission
212 No. Market
Wichita, Kansas 67202

WELL PLUGGING RECORD

NORTH

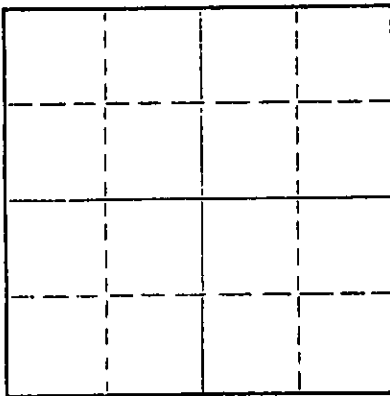

Locate well correctly on above
Section Plat

Sedgwick County, Sec 18 Twp. 25 Rge. (E) 2 (W)
Location as "NE/CNWKSWK" or footage from lines C SW NE
Lease Owner J. A. Allison
Lease Name Williams Well No. 1 "A"
Office Address 1415 Wichita Plaza - Wichita, Kansas
Character of Well (completed as Oil, Gas or Dry Hole) dry
Date well completed 8-4 19 70
Application for plugging filed 8-4 19 70
Application for plugging approved 8-4 19 70
Plugging commenced 7:15 8-4 19 70
Plugging completed 9:15 AM 8-4 19 70
Reason for abandonment of well or producing formation dry
If a producing well is abandoned, date of last production 19
Was permission obtained from the Conservation Division or its agents before plugging was commenced? yes
Name of Conservation Agent who supervised plugging of this well Ted Dewey - Augusta, Kansas
Producing formation Depth to top Bottom Total Depth of Well 3989 Feet
Show depth and thickness of all water, oil and gas formations.

OIL, GAS OR WATER RECORDS

CASING RECORD

FORMATION	CONTENT	FROM	TO	SIZE	PUT IN	PULLED OUT
		0	196	10 3/4	196	0

Describe in detail the manner in which the well was plugged, indicating where the mud fluid was placed and the method or methods used in introducing it into the hole. If cement or other plugs were used, state the character of same and depth placed, from feet to feet for each plug set.

Plug @ 190' w/25 sx thru drill pipe - mud up to 40' & plug w/10 sx
and 2 in rat hole

RECEIVED
STATE CORPORATION COMMISSION
AUG 11 1970
CONSERVATION DIVISION
Wichita, Kansas

(If additional description is necessary, use BACK of this sheet)
Name of Plugging Contractor B & B Drilling, Inc.
Address 720 Union Center - Wichita, Kansas

STATE OF Kansas, COUNTY OF Sedgwick, ss.

Bill Lahar (employee of owner) or (owner or operator) of the above-described well, being first duly sworn on oath, says: That I have knowledge of the facts, statements, and matters herein contained and the log of the above-described well as filed and that the same are true and correct. So help me God.

(Signature)

Bill Lahar

720 Union Center - Wichita, Kansas

(Address)

SUBSCRIBED AND SWORN to before me this 10th day of August, 19 70

Alma A. Pearson

Notary Public.

My commission expires May 31, 1970

B & B DRILLING, INC.
207 Petroleum Building
Wichita, Kansas 67202

August 10, 1970

18-95-2W

DRILLERS LOG

Re: Williams #1 "A"
C SW NE Section 18-258-2W
Sedgwick County, Kansas

OPERATOR: J. A. Allison
Contractor: B & B Drilling, Inc.
Commenced: July 24, 1970
Completed: August 4, 1970
Total Depth: 3989'

Ran 10 3/4" casing @ 196 w/215 sx

0	120	Surface
120	196	Sand & Shale
196	515	Shale
515	606	Shale
606	910	Shale & Lime
910	1113	Shale & Lime
1113	1365	Shale w/Lime
1365	1835	Shale
1835	2155	Shale
2155	2352	Shale & Lime Streaks
2352	2660	Shale & Lime
2660	2927	Shale w/Lime
2927	2989	Lime
2989	3210	Lime w/Shale
3210	3490	Lime & Chert
3490	3650	Lime w/Streaks of Chert
3650	3777	Lime & Shale w/ Chert
3777	3806	Lime & Chert
3806	3877	Lime w/Shale
3877	3989	Lime w/Shale
3989		Total Depth

RECEIVED
STATE CORPORATION COMMISSION
AUG 11 1970
CONSERVATION DIVISION
Wichita, Kansas

D & A.

We certify the above and foregoing to be true and correct copy of the log on the #1 "A" Williams, located in Sedgwick County, Kansas

Bill Lohar President

Alma A. Neisen Notary Public
Subscribed and sworn to before me this 10th day of August, 1970. My commission expires May 31, 1974