

WELL PLUGGING RECORD


OR

FORMATION PLUGGING RECORD

Strike out upper line when reporting plugging off formations.

STATE OF KANSAS
STATE CORPORATION COMMISSION
Give All Information Completely
Make Required Affidavit
Mail or Deliver Report to:
Conservation Division
State Corporation Commission
800 Bittling Building
Wichita, Kansas

NORTH

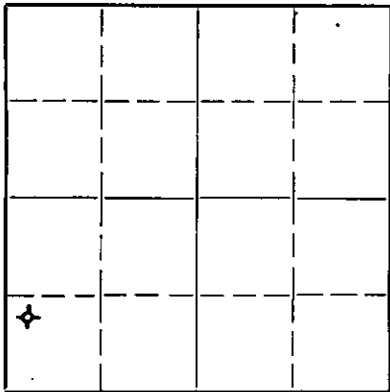

Locate well correctly on above Section Plat

Sedgwick County. Sec. 14 Twp. 25-S Rge. (E) 2 (W)
Location as "NE 1/4 NW 1/4 SW 1/4" or footage from lines. 330' FNL & 990' FSL of Sec.
Lease Owner Lion Oil Refining Company
Lease Name Dora Creasser Well No. 1.
Office Address 905 Union National Bank Building
Character of Well (completed as Oil, Gas or Dry Hole) Dry Hole
Date well completed May 26th. 19 43
Application for plugging filed May 26th. 19 43
Application for plugging approved May 26th. 19 43
Plugging commenced May 26th. 19 43
Plugging completed May 27th. 19 43
Reason for abandonment of well or producing formation Dry Hole

If a producing well is abandoned, date of last production 19
Was permission obtained from the Conservation Division or its agents before plugging was commenced? Yes

Name of Conservation Agent who supervised plugging of this well Mr. Durkee
Producing formation Depth to top Bottom Total Depth of Well 4095 Feet
Show depth and thickness of all water, oil and gas formations.


OIL, GAS OR WATER RECORDS

CASING RECORD

Formation	Content	From	To	Size	Put In	Pulled Out
Kansas City	Dry	2540		8-5/8"	403	None
Mississippi	Dry	3405				
Viola	Dry	3887				
Simpson	Dry	3905				
Arbuckle	Dry	4007				

Describe in detail the manner in which the well was plugged, indicating where the mud fluid was placed and the method or methods used in introducing it into the hold. If cement or other plugs were used, state the character of same and depth placed, from feet to feet for each plug set.

Heavy mud up to bottom of Surface casing.
Plug set at 390' - Cemented with 15 sacks.
Plug set at 26' - Cemented with 15 sacks.

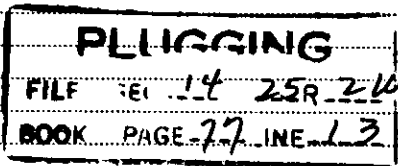

(If additional description is necessary, use BACK of this sheet)

Correspondence regarding this well should be addressed to Mr. W. F. Bowser
Address Lion Oil Refining Company, 905 Union National Bank Building, Wichita, Kansas


STATE OF COUNTY OF, SS.

(employee of owner) or (owner or operator) of the above-described well, being first duly sworn on oath, says: That I have knowledge of the facts, statements, and matters herein contained and the log of the above-described well as filed and that the same are true and correct. So help me God.

(Signature) Vernon Hayes

SUBSCRIBED AND SWORN to before me this 9th day of June

My commission expires Aug 2, 1943

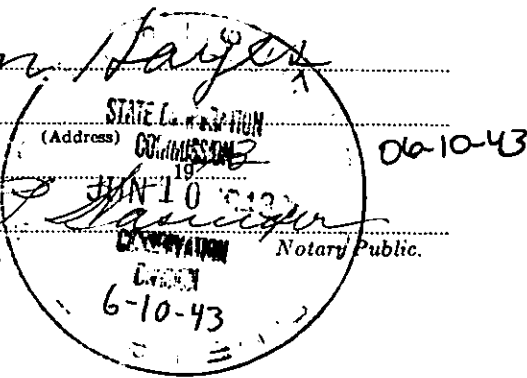

LION OIL REFINING COMPANY
El Dorado, Arkansas

Greasser Well No. 1

330 ft. east and 330 ft. south
of the NW corner of the SW $\frac{1}{4}$
of the S $\frac{1}{2}$ of Sec. 14,
Twp. 25S, Rge. 2W, Sedgwick
County, Kansas

Elevation: 1384'

Contractor: The R. W. Rine Drilling Company
Commenced: May 6, 1943 - Completed: May 28, 1943

LOG

Sand	Top- 170	
Shale and Shells	170- 403	8-5/8" casing cemented at 403'
Shale	403- 435	
Anhydrite	435- 450	
Lime	450- 590	
Shale	590- 615	
Slate and Lime	615- 730	
Lime	730- 800	
Sand	800- 835	
Lime and Sand	835- 955	
Lime and Shale	955-1355	
Shale	1355-2090	
Lime	2090-2168	
Lime and Shale	2168-2400	
Shale	2400-2519	
Lime and Shale	2519-2547	
Lime	2547-3080	Top Kansas City Lime 2540'
Shale	3080-3130	" Mississippi Lime 3405'
Lime	3130-3148	" Viola Lime 3887'
Shale	3148-3207	" Simpson Sand 3905'
Lime	3207-3265	" Arbuckle Lime 4007'
Shale	3265-3328	
Lime and Shale	3328-3373	
Shale and Sand	3373-3418	
Hard Lime and Chert	3418-3448	
Chert	3448-3472	
Chert and Lime	3472-3656	
Chert	3656-3750	
Lime	3750-3771	
Lime and Shale	3771-3853	
Lime	3853-3927	
Sand and Shale	3927-3936	Halliburton Drill Stem Test @ 3936' -
Lime and Shale	3936-3956	15' of mud.
Shale	3956-3977	
Sandy Shale	3977-4008	
Lime	4008-4095	

Total Depth - 4095
Dry Hole - Plugged and Abandoned

State of Kansas) ss.
County of Barton)

I, C. H. Todd, do hereby certify that the above is a true and correct copy of the log of Greasser Well No. 1 located 330' east and 330' south of the NW corner of the SW $\frac{1}{4}$ of the SW $\frac{1}{4}$ of Section 14, Township 25S, Range 2W, Sedgwick County, Kansas.

Sworn to and subscribed before me this 3rd day of June, 1943.

Edward O'Brien
(Notary Public)

My commission expires Feb 1, 1946.