

15-171-43354-0000

STATE OF KANSAS
STATE CORPORATION COMMISSION

WELL PLUGGING RECORD


OR

FORMATION PLUGGING RECORD

Strike out upper line
when reporting plugging
of formations.

Give All Information Completely
Make Required Affidavit
Mail or Deliver Report to:
Conservation Division,
State Corporation Commission,
800 Bitting Building,
Wichita, Kansas.

NORTH

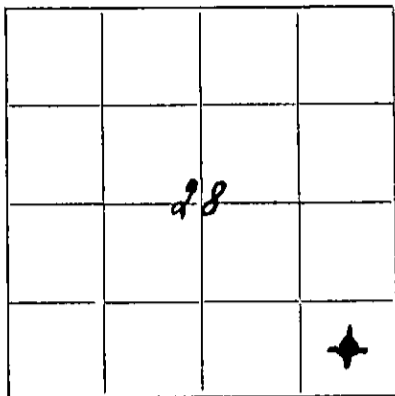

Locate well correctly on above
640 A. Plat

Scott County. Sec. 28 Twp. 20-S Rge. (E) 33 (W)
Lease Name. Clayton Mark Well No. 1
Lease Owner. Atlantic Oil Producing Company
Office Address. Great Bend, Kansas.
Character of Well (Oil, Gas or Dry) Dry Total Depth of Well 5645 Feet
Date, well, completed. July 3rd, 1935.
Application for plugging ~~XXXXXXXXXX~~ July 5th, 1935.
Application for plugging approved. July 5th, 1935.
Plugging Commenced. July 6th, 1935.
Plugging Completed. July 6th, 1935.
Reason for abandonment of well or producing formation. Dry

If a producing well is abandoned, date of last production. 1935

Was permission obtained from the Conservation Division or its agents before plugging was commenced? Yes

Name of Conservation Officer who supervised plugging of this well. C. S. McGhee

Producing formation. Depth to top. Bottom.

Show depth and thickness of all water, oil and gas formations.

OIL, GAS OR WATER RECORDS

CASING RECORD

Formation	Content	From	To	Size	Put In	Pulled Out
				15-1/2"	248'	None

Describe in detail the manner in which the well was plugged, indicating where the mud fluid was placed and the method or methods used in introducing it into the hole. If cement or other plugs were used, state the character of same and depth placed, from.....feet to.....feet for each plug set.

Hole filled with mud laden fluid from bottom to within 175 feet of top. Weed plug was then placed at this depth with 30 sacks of cement on top thereof. Hole was then filled with mud laden fluid to within 12 feet of top with the last 12 feet being filled with 10 sacks of cement.

28 70 33
10 36

20WD
07-18-35

(If additional description is necessary use BACK of this sheet)

Does the above conform strictly to the Conservation Division regulations? Yes

Was exception made? No If so describe.

Correspondence regarding this well should be addressed to. Atlantic Oil Producing Company

Address. P. O. Box 17, Great Bend, Kansas.

STATE OF Kansas, COUNTY OF Barton, ss.

Dovey A. Jordan (employee of owner) ~~XXXXXXXXXX~~

being first duly sworn on oath, says: That I have knowledge of the facts, statements, and matters herein contained and the log of the above-described well as filed and that the same are true and correct. So help me God.

(Signature) Dovey A. Jordan

Box 17, Great Bend, Kansas.
(Address)

SUBSCRIBED AND SWORN TO before me this 18th day of July, 1935.

My commission expires April 27, 1939

R.R. Rinkes
Notary Public.

**FIGURES INDICATE
PAGE OF SUMMARY**


show of 011

T. D.