

RECEIVED

15-171-20198-00-60

MAY 18 1982

FORM CP-4

STATE OF KANSAS  
STATE CORPORATION COMMISSION  
CONSERVATION DIVISION  
P. O. BOX 17027  
WICHITA, KANSAS 67217

IREX Corp

WELL PLUGGING RECORD

Scott County, Sec 27 Twp 20S Rge (E) 33(W)

Location as "NE/CNW6SW4" or footage from lines NE SW  
Lease Owner IREX Corp.

Lease Name SAVOLT Well No. 1

Office Address P.O. Box 508 Protection, KS 67129

Character of Well (completed as Oil, Gas or Dry Hole)

Date well completed January 25 19 81

Application for plugging filed 19 81

Application for plugging approved 19


Plugging commenced April 5 19 82

Plugging completed April 8 19 82

Reason for abandonment of well or producing formation not commercially productive

If a producing well is abandoned, date of last production 19

Was permission obtained from the Conservation Division or its agents before plugging was commenced? Yes

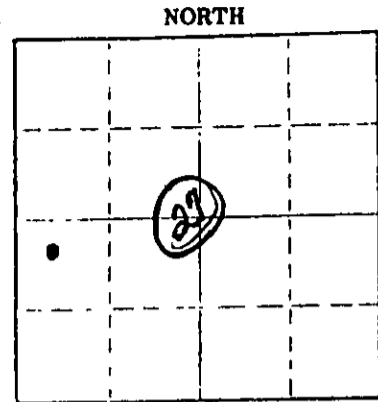

Locate well correctly on above Section Plot

Name of Conservation Agent who supervised plugging of this well Clarence Thomas

Producing formation Depth to top Bottom Total Depth of Well 4780 Feet

Show depth and thickness of all water, oil and gas formations.

OIL, GAS OR WATER RECORDS

CASING RECORD

FORMATION	CONTENT	FROM	TO	SIZE	PUT IN	PULLED OUT
				4 1/2"	4780'	359.59'
				8 5/8"	564'	None

RECEIVED  
STATE CORPORATION COMMISSION  
JUN - 5 1982  
CONSERVATION DIVISION  
Wichita, Kansas

Describe in detail the manner in which the well was plugged, indicating where the mud fluid was placed and the method or methods used in introducing it into the hole. If cement or other plugs were used, state the character of same and depth placed, from feet to feet for each plug set.

4-6-82 Set cast iron bridge plug to 4000' + 10' cement on top. Shot pipe at 1407'.

4-7-82 Pumped 50 sacks cement from 1400' - 1300'. Shot and started pipe at 360'. Pumped 50 sacks cement from 360' - 260'. Finished pulling pipe out of hole. Capped surface with 10 sacks cement 3-33'.

4-8-82 Cut off well head and welded on a steel plate.

(If additional description is necessary, use BACK of this sheet)

Name of Plugging Contractor Reeves & Wilson, Inc. Permit #530

Address P.O. Box 963 Woodward, Oklahoma 73802

STATE OF Colorado COUNTY OF Denver ss.

Dudley W. Brown, V. President Operations (employee of owner) of IREX Corp. of the above-described well, being first duly sworn on oath, says: That I have knowledge of the facts, statements, and matters herein contained and the log of the above-described well as filed and that the same are true and correct. So help me God.

(Signature) DW Brown  
1670 Broadway, Suite 3301, Denver, Colo. 80202  
(Address)

Subscribed and sworn to before me this 26th day of May 19 82

My commission expires June 9, 1985  
Mary J. Warren Notary Public

15-171-20198-00-00

IREX Corp.

Amoco Building  
1670 Broadway, Suite 3301  
Denver, Colorado 80202  
(303) 861-4002

May 26, 1982

State of Kansas  
State Corporation Commission  
Conservation Division  
P. O. Box 17207  
Wichita, Kansas 67217

Re: SAVOLT-1

Dear Eloise:

Per our conversation May 26, 1982, I am sending this to your attention, since you basically know the story of the situation of the status of this Well Plugging Record. I went ahead and had it signed and notarized. If you have any further questions that may arise in this matter, please call me.

Sincerely,



Linda L. Drennen  
Well Records Supervisor

:lld

Enclosures

P.S. I guess that I'll try this again, since I have the wrong address for the 1st try.

RECEIVED  
STATE CORPORATION COMMISSION

JUN - 3 1982

CONSERVATION DIVISION  
Wichita, Kansas