

15-171-20004-00-00

GP

STATE OF KANSAS  
STATE CORPORATION COMMISSION

Form CP-4

Give All Information Completely  
Make Required Affidavit  
Mail or Deliver Report to:  
Conservation Division  
State Corporation Commission  
211 No. Broadway  
Wichita, Kansas

WELL PLUGGING RECORD

Scott County, Sec. 26 Twp. 20S Rge. 33 (E) (W)

Location as "NE/CNWxSWx" or footage from lines C SW SE

Lease Owner W. J. Coppinger et al

Lease Name Beach Well No. 1

Office Address 925 Sutton Place, Wichita, Kansas 67202

Character of Well (completed as Oil, Gas or Dry Hole) Dry Hole

Date well completed August 11, 1967 19

Application for plugging filed August 12, 1967 19

Application for plugging approved August 12, 1967 19


Plugging commenced August 12, 1967 19

Plugging completed August 12, 1967 19

Reason for abandonment of well or producing formation D & A

If a producing well is abandoned, date of last production 19

Was permission obtained from the Conservation Division or its agents before plugging was commenced?

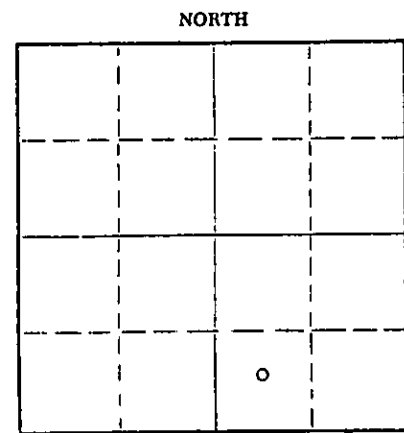

Locate well correctly on above Section Plat

Name of Conservation Agent who supervised plugging of this well W. L. Nichols

Producing formation \_\_\_\_\_ Depth to top \_\_\_\_\_ Bottom \_\_\_\_\_ Total Depth of Well 4935' Feet

Show depth and thickness of all water, oil and gas formations.

OIL, GAS OR WATER RECORDS

CASING RECORD

FORMATION	CONTENT	FROM	TO	SIZE	PUT IN	PULLED OUT
				8 5/8"	295'	None

Describe in detail the manner in which the well was plugged, indicating where the mud fluid was placed and the method or methods used in introducing it into the hole. If cement or other plugs were used, state the character of same and depth placed, from \_\_\_\_\_ feet to \_\_\_\_\_ feet for each plug set.

946 to 575' - 115 sacks cement

301 to 240' - 20 sacks cement

40 to 0' - 10 sacks cement

By Halliburton

AUG 22 1967

CONSERVATION DIVISION  
Wichita, Kansas

(If additional description is necessary, use BACK of this sheet)

Name of Plugging Contractor Mahoney Drilling Company, Inc.

Address Box 1257 Liberal, Kansas

STATE OF Kansas, COUNTY OF Sedgwick, ss.

F. W. Mallonee, one of the \_\_\_\_\_ (employee of owner) or (owner or operator) of the above-described well, being first duly sworn on oath, says: That I have knowledge of the facts, statements, and matters herein contained and the log of the above-described well as filed and that the same are true and correct. So help me God.

(Signature) F. W. Mallonee

925 Sutton Place  
(Address)

SUBSCRIBED AND SWORN TO before me this 16th day of August, 1967

My commission expires 4-23-67

Leola Lynskey  
Notary Public.



15-171-20004-00-88

DRILLING LOG

LEASE OWNER Mallonee-Coppinger Operations, Inc. ADDRESS 925 Sutton Place, Wichita, Ks.  
LEASE Beach #1 COUNTY Scott, Kansas DESCRIPTION C SW-SE 26-20S-33W

CASING: SIZE 8 5/8 WEIGHT 23# AMOUNT 295 KB

CEMENT: AMOUNT 275 Sx. CIRCULATED: Yes X No       

CASING: SIZE        WEIGHT        AMOUNT       

CEMENT: AMOUNT        Sx. CIRCULATED: Yes        No       

PLUG SET: 575 Ft. TO 946 Ft. CEMENT 115 Sx.  
240 Ft. TO 301 Ft. CEMENT 20 Sx.  
40 Ft. TO -0- Ft. Cement 10 Sx.

FORMATION AND DEPTH

Sand and Clay	0	TO	220
Shale	220	TO	297
Clay - Shale	297	TO	325
Clay - Sane	325	TO	1260
Shale - Anhydrite	1260	TO	1850
Shale - Lime	1850	TO	3812
Lime	3812	TO	4285
Lime - Shale	4285	TO	4385
Lime	4385	TO	4935
T. D.	4935	TO	-
		TO	
		TO	
		TO	
		TO	
		TO	
		TO	
		TO	

RECEIVED  
STATE OF KANSAS COMMISSIONER OF  
AUG 22 1967  
CONSERVATION DIVISION  
Wichita, Kansas

THIS IS A TRUE AND EXACT COPY OF THE FORMATIONS TAKEN FROM THE DAILY DRILLING REPORTS.

Executed this 14th day of August 19 67

By George W. Carnahan

IN WITNESS WHEREOF, I have hereunto set my hand and affixed my official seal the day and year above written.

Jolene Dorsett  
Notary Public

MY COMMISSION EXPIRES: January 31, 1971

