


STATE OF KANSAS
STATE CORPORATION COMMISSION

WELL PLUGGING RECORD

Give All Information Completely
Make Required Affidavit
Mail or Deliver Report to
Conservation Division
State Corporation Comm.
245 North Water
Wichita, KS 67202

Scott County. Sec. 26 Twp. 20S Rge. 33 SE/W
Location as "NE/CNW $\frac{1}{4}$ SW $\frac{1}{4}$ " or footage from lines
C SW NW

Lease Owner Funk Petroleum
Lease Name Savolt Well No. 1-26
Office Address P.O. Box 1578, Liberal, Kansas 67901
Character of Well (Completed as Oil, Gas or Dry Hole) Dry Hole
Date Well completed 11-14-78 19 78
Application for plugging filed 11-14-78 19 78
Application for plugging approved 11-13 (verbal) 19 78
Plugging commenced 11-14 19 78
Plugging completed 11-14 19 78
Reason for abandonment of well or producing formation _____

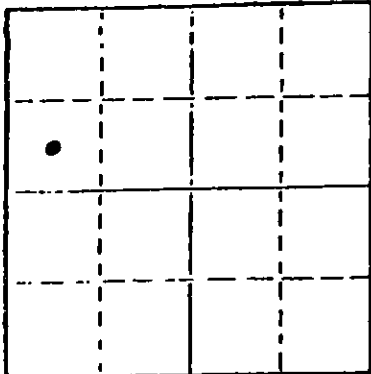

Locate well correctly on above Section Plot

If a producing well is abandoned, date of last production 19 _____
Was permission obtained from the Conservation Division or its agents before plugging was commenced? Yes

Name of Conservation Agent who supervised plugging of this well Bill Owens
Producing formation _____ Depth to top _____ Bottom _____ Total Depth of Well 5000'
Show depth and thickness of all water, oil and gas formations.

OIL, GAS OR WATER RECORDS

CASING RECORD

FORMATION	CONTENT	FROM	TO	SIZE	PUT IN	PULLED OUT
				8 5/8	530'	None

Describe in detail the manner in which the well was plugged, indicating where the mud fluid was placed and the method or methods used in introducing it into the hold. If cement or other plugs were used, state the character of same and depth placed, from _____ feet to _____ feet for each plug set.

Plugged well as follows: 50 sacks @ 700'
50 sacks @ 530'
12 sacks @ 40'
3sacks in rat hole

RECEIVED
STATE CORPORATION COMMISSION
NOV 10 1978
CONSERVATION DIVISION
Wichita, Kansas

(If additional description is necessary, use BACK of this sheet)

Name of Plugging Contractor Halliburton, Liberal, Kansas

STATE OF Kansas COUNTY OF Seward, ss.
Harold K. Frauli, Agent (employee of owner) or (owner or operator)
of the above-described well, being first duly sworn on oath, says: That I have knowledge of the facts, statements, and matters herein contained and the log of the above-described well as filed and that the same are true and correct. So help me God.

(Signature) Harold K. Frauli
P.O. Box 1578, Liberal, Kansas
(Address)

SUBSCRIBED AND SWORN TO before me this 15th day of November, 198

RHENDA J. VAN METER
Seward County, Ks.
My Appt. Exp. Feb. 12, 1980

Rhenda J. Van Meter
Notary Public.

My commission expires _____