


Give All Information Completely  
Make Required Affidavit  
Mail or Deliver Report to:  
Conservation Division  
State Corporation Commission,  
800 Bitting Building,  
Wichita, Kansas

**RECEIVED**  
DEC 3 1936  
*W*

15-171-43350-00-00  
**WELL PLUGGING RECORD**  
OR  
**FORMATION PLUGGING RECORD**

Strike out upper line  
when reporting plugging  
off formations.

NORTH

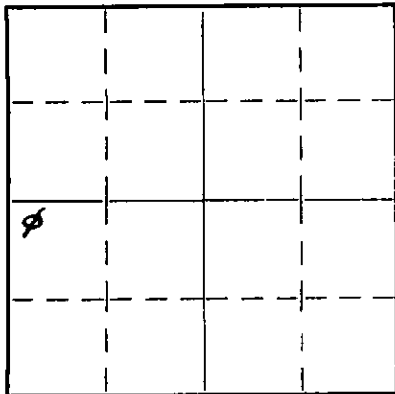

Locate well correctly on above  
Section Plat

Scott

County. Sec. 23. Twp 20. S. Rge. 33. (W)

Location as "NE $\frac{1}{4}$ NW $\frac{1}{4}$ SW $\frac{1}{4}$ " or footage from lines 340 ft. East of West line and  
Lease Owner Robert Watchorn 330 ft. South of North line of  
Lease Name Electa Ball Spangler, S $\frac{1}{4}$  Well No. 1  
Office Address 2715 First National Bldg. Oklahoma City, Okla.  
Character of Well (Completed as Oil, Gas or Dry Hole) Dry hole  
Date, well completed Nov. 18, 1936  
Application for plugging filed November 18, 1936  
Application for plugging approved November 21, 1936  
Plugging Commenced November 19, 1936  
Plugging Completed November 26, 1936  
Reason for abandonment of well or producing formation Dry hole

If a producing well is abandoned, date of last production - 193

Was permission obtained from the Conservation Division or its agents before plugging was commenced? **Yes**

Name of Conservation Agent who supervised plugging of this well C. T. Alexander, Great Bend, Kansas.

Producing formation Depth to top Bottom Total Depth of Well 5509 Feet

Show depth and thickness of all water, oil and gas formations.

OIL, GAS OR WATER RECORDS

CASING RECORD

Formation	Content	From	To	Size	Put In	Pulled Out
				10 "	240'	None
				7 "	4605'	1200'
				5 "	5080'	5080'

Describe in detail the manner in which the well was plugged, indicating where the mud fluid was placed and the method or methods used in introducing it into the hole. If cement or other plugs were used, state the character of same and depth placed, from feet to feet for each plug set.

Hole filled with mud from 5509 to 5400 ft., put in with dump bailer.  
Bridged at 5400 feet, 30 ft. of cement put in with dump bailer, to 5370 ft.  
Filled with mud from 5370 to 4600 feet, cement plug from 4600 to 4570 ft.  
Pipe filled with cement from 1850 to 1200 feet, and filled with mud from 1200 to 240 feet. Cement in 10" pipe from 240 ft. to top.

23 20 33 W  
27 27

(If additional description is necessary use BACK of this sheet)

Correspondence regarding this well should be addressed to Mr. Robert Watchorn.  
Address 2715 First National Building, Oklahoma City, Oklahoma.

STATE OF Kansas, COUNTY OF Scott, SS.

John I. Ramsay (employee of owner) of the above-described well,  
being first duly sworn on oath, says: That I have knowledge of the facts, statements, and matters herein contained and the log of the above-described well as filed and that the same are true and correct. So help me God.

(Signature) John I Ramsay  
Shallow Water Runs  
(Address)

SUBSCRIBED AND SWORN to before me this 30th day of November, 1936

My commission expires May 10th 1940

Drilled by Robert Watchorn, 330' from West line, 330' from North line, of the Southwest Quarter of Section 23, Township 20 South, Range 33 West, Scott County, Kansas.

Elevation:

Drilling commenced: July 21, 1936.  
 Drilling completed: Nov. 18, 1936.

Surface soil	0 - 240
Chalk	240 - 300
Shale	300 - 675
Lime & sand shale	675 - 850
Sand shale	850 - 900
Shale and shells	900 - 1065
Sandy shale	1065 - 1140
Red bed	1140 - 1300
Red rock and gyp shells	1300 - 1490
Red rock and gyp shells	1490 - 1600
Red rock & shells	1600 - 1772
Shale shells	1772 - 2040
Red rock & gyp	2040 - 2065
Red rock	2065 - 2085
Lime & shale breaks	2085 - 2170
B. lime, red	2170 - 2260
B. lime	2260 - 2335
B. lime	2335 - 2415
Lime	2415 - 3005
B. Lime	3005 - 3040
Lime	3040 - 3120
Lime	3120 - 3310
Broken lime	3310 - 3430
Lime	3430 - 3625
Broken lime	3625 - 3805
Lime, broken	3805 - 3875
Broken lime	3875 - 4040
Lime	4040 - 4085
Broken lime	4085 - 4140
Lime	4140 - 4200
Lime & shale breaks	4200 - 4280
Lime	4280 - 4605
Core	4605 - 4615
Gray shale	4615 - 4630
Sandy shale	4630 - 4664
Sandy lime	4664 - 4676
Lime	4676 - 4688
Sand lime	4688 - 4694
Lime	4694 - 4770
Lime	4770 - 5075
1/2 boiler water	5050 to 5053
Water sand	5075 - 5083
4 boilers per hour	
Lime	5083-- 5098
Correction in measurement	5098 - 5110
Lime	5110 - 5130
Sandy lime	5130 - 5140
Lime	5140 - 5181
Lime chalk	5181 - 5184
Lime	5184 - 5509
Total depth	- 5509

CASING RECORD

10"	240'	Left in
7" O.D.	3405'	Left in
7" O.D.	1200'	Pulled
5"	5080'	Pulled