

15-171-20181-00-00


STATE OF KANSAS
STATE CORPORATION COMMISSION

Form CP-4

Give All Information Completely
Make Required Affidavit
Mail or Deliver Report to:
Conservation Division
State Corporation Commission
211 No. Broadway
Wichita, Kansas

WELL PLUGGING RECORD

NORTH

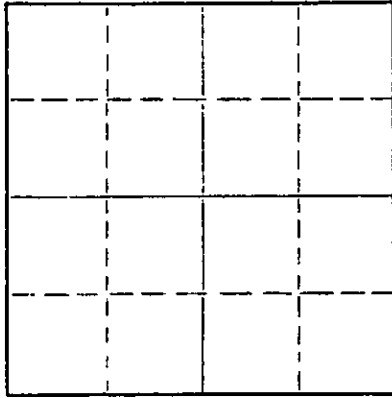

Locate well correctly on above
Section Plat

SCOTT County. Sec. 22 Twp. 20S Rge. 33 (E) W (W)
Location as "NE/CNWxSWx" or footage from lines C NW/4 SW/4
Lease Owner Woolsey Petroleum Corporation
Lease Name E. DAGUE Well No. 1
Office Address 300 W. Douglas, Suite 400, Wichita, Kansas 67202
Character of Well (completed as Oil, Gas or Dry Hole) Dry Hole
Date well completed 11-24-79 1979
Application for plugging filed _____ 19____
Application for plugging approved _____ 19____
Plugging commenced 11-23-79 1979
Plugging completed 11-23-79 1979
Reason for abandonment of well or producing formation Dry Hole

If a producing well is abandoned, date of last production _____ 19____
Was permission obtained from the Conservation Division or its agents before plugging was commenced? Yes

Name of Conservation Agent who supervised plugging of this well Gilbert Balthazor
Producing formation _____ Depth to top _____ Bottom _____ Total Depth of Well 5020 Feet
Show depth and thickness of all water, oil and gas formations.

OIL, GAS OR WATER RECORDS

CASING RECORD

FORMATION	CONTENT	FROM	TO	SIZE	PUT IN	PULLED OUT
				8 5/8"	569'	None

Describe in detail the manner in which the well was plugged, indicating where the mud fluid was placed and the method or methods used in introducing it into the hole. If cement or other plugs were used, state the character of same and depth placed, from _____ feet to _____ feet for each plug set.

- Set Plug @ 750' with 60 sacks cement
- Set Plug @ 500' with 30 sacks cement
- Set Plug @ 40' with 10 sacks cement
- Set Plug in Rat Hole with 5 sacks cement

(If additional description is necessary, use BACK of this sheet)
Name of Plugging Contractor Earl F. Wakefield, Inc.
Address 300 West Douglas, Suite 500, Wichita, Kansas 67202


STATE OF Kansas, COUNTY OF Sedgwick, ss.
Mikeal K. Maune (employee of owner) or (owner or operator) of the above-described well, being first duly sworn on oath, says: That I have knowledge of the facts, statements, and matters herein contained and the log of the above-described well as filed and that the same are true and correct. So help me God.

(Signature) Mikeal K. Maune
300 West Douglas, Suite 400, Wichita, Ks. 67202
(Address)

SUBSCRIBED AND SWORN TO before me this 4th day of January, 19 80

My commission expires Sept 29, 1982

Bruce C. Ward
Notary Public.

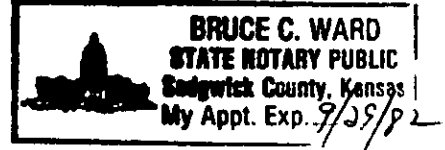

15-171-20181-00-00

KANSAS DRILLER'S LOG

LEASE: #1 E. DAGUE
OWNER: WOOLSEY PETROLEUM CORPORATION
CONT: EARL F. WAKEFIELD, INC.
SPUD: 11-6-79
CMMP: 11-24-79

LOCATION: SECTION 22-20S-33W
SCOTT COUNTY,
KANSAS
CASING: 8 5/8" SET @ 569'
D & A @ 5020'

Soil, Sand & Blue Clay	570
Shale, Red Bed & Anhydrite Streaks	1425
Shale, Anhydrite, Red Bed & Sand	1735
Shale - Lime	2112
Shale & Shells	2310
Shale & Shells & Anhydrite	2490
Shale - Lime	2600
Lime & Shale	2675
Lime	2685
Lime - Shale	3010
Lime	3605
Lime - Shale	3730
Lime	4520
Lime - Shale	4600
Lime	5020
D & A	5020

STATE OF KANSAS)
) ss.
COUNTY OF SEDGWICK)

I, William C. Wakefield, do hereby certify that this is a true and correct log on the #1 E. DAGUE, located SECTION 22-20S-33W, SCOTT COUNTY, KANSAS, as shown by the daily drilling reports.

EARL F. WAKEFIELD, INC.

By: William C. Wakefield
William C. Wakefield

Subscribed and Sworn to before me this 30th day of November, 1979.

My Appointment Expires:
May 7, 1983

Jane E. Trueblood
Jane E. Trueblood - - Notary Public

