

FOR USE:

EFFECTIVE DATE: 7-26-94

DISTRICT # 1
STAT. X Yrs. 10

SKIDDING RIG FROM OILMEN #1

State of Kansas

NOTICE OF INTENTION TO DRILL

Must be approved by the K.S.C. five (5) days prior to commencing well

Expected Spud Date July 26, 1994
Month July Day 26 Year 1994

OPERATOR: License # 3869
Name: IMPERIAL OIL PROPERTIES, INC.
Address: 212 N. Market #513
City/State/Zip: Wichita, KS 67202-2013
Contact Person: Robert L. Williams, Jr.
Phone: (316) 265-6977

CONTRACTOR: License # 5892
Name: BERENTZ DRILLING COMPANY, INC.

Well Drilled For: Well Class: Type Equipment:

 Oil ... BHP 200 ... Infield Mud Rotary
 Gas ... Storage ... Pool BHP, ... Air Rotary
 GWD ... Disposal ... Wildcat ... Cable
 Seismic; ... & of holes ... Other
 Other
If QWD: old well information as follows:

Operator:
Well Name:
Comp. Date: Old Total Depth:

Directional, Deviated or Horizontal wellbore? ... yes ... no
If yes, true vertical depth:
Bottom Hole Location:

AFFIDAVIT

The undersigned hereby affirms that the drilling, completion and eventual plugging of this well will comply with K.S.A. 35-109, et. seq.
It is agreed that the following minimum requirements will be met:

1. Notify the appropriate district office prior to spudding or wells;
2. A copy of the approved notice of intent to drill shall be posted on each drilling rig;
3. The minimum amount of surface pipe as specified below shall be set by circulating cement to the top; in all cases, surface pipe shall be set through all unconsolidated materials plus a minimum of 20 feet into the underlying formation;
4. If the well is dry hole, an agreement between the operator and the district office on plug length and placement is necessary prior to plugging;
5. The appropriate district office will be notified before well is either plugged or production casing is cemented in;
6. IF AN ALTERNATE TO COMPLETION, PRODUCTION PIPE SHALL BE EXEMPTED FROM BELOW ANY USABLE WATER TO SURFACE WITHIN 120 DAYS OF SPUD DATE. IN ALL CASES, NOTIFY DISTRICT OFFICE PRIOR TO ANY CEMENTING.

I hereby certify that the statements made herein are true and to the best of my knowledge and belief.

Date: July 26, 1994, Signature of Operator or Agent: Robert L. Williams Title: Agent

X-reference
K15-169-20311

FOR USE ONLY
API # 15: 169 - 20312-00-00
Conductor pipe required NONE feet
Minimum surface pipe required 200 feet per Alt. 0X
Approved by: CB 7-26-94

This authorization expires: 1-26-95
(This authorization void if drilling not started within 6 months of effective date.)
Spud date: _____ Agent: _____

EXHIBIT TO:

- File Drill Pit Application (form 329-1) with Intent to Drill;
- File Completion Form 4CD-1 within 120 days of spud date;
- File seismic attribution plot according to field operation orders;
- Notify appropriate district office 48 hours prior to workover or re-entry;
- Submit plugging report (49-4) after plugging is completed;
- Obtain written approval before disposing or injecting salt water.

Mall to: Conservation Division, 200 Colorado Derby Building, 202 W. First St., Wichita, Kansas 67202-1234.

FORM 501-7
FORM MUST BE TYPE
FORM MUST BE FILLED
ALL BLANKS MUST BE FILLED

Spec Approx 100' SSW of the Sec. 554
... SW. SW. sec. 20. Twp. 16. R. Ag. 4. X. No
..... 604 feet from South / North line of section
..... 604 feet from East / West line of section
IS SECTION X REGULAR IRREGULAR
(NOTE: Locate well on the Section Plat on Reverse Side)
County: SALINE
Lease Name: OLEEN Well Nr. 1A
Field Name: N/A
Is this a Prorated/Shared Field? ... yes X, no
Target Formation(s): Mqqquakel & SIMPSON
Nearest lease or unit boundary: 554 feet
Ground Surface Elevation: feet NS
Water well within one-quarter mile: ... yes X, no
Public water supply well within one mile: ... yes X, no
Depth to bottom of fresh water: 180
Depth to bottom of usable water: 180
Surface Pipe by Alternate: ... X. 1 3
Length of Surface Pipe Planned to be set: ... 500
Length of Conductor pipe required: ... NONE
Projected Total Depth: 3725
Formation at Total Depth: ... SIMPSON
Water sources for drilling operations:
... well X, farm pond other
DNR Permit #:
Well cores to be taken: yes X, no
If yes, proposed zones:

Rec'd. 07-26-1994 | 20
| 16 | 4

IN ALL CASES PLOT THE INTENDED WELL ON THE PLAT BELOW

PLAT OF ACREAGE ATTRIBUTABLE TO A WELL IN A PRORATED OR SPACED FIELD

If the intended well is in a prorated or spaced field, please fully complete this side of the form. If the intended well is in a prorated or spaced field complete the plat below showing that the well will be properly located in relationship to other wells producing from the common source of supply. Please show all the wells within 1 mile of the boundaries of the proposed acreage attribution unit for gas wells and within 1/2 mile of the boundaries of the proposed acreage attribution unit for oil wells.

API NO. 15.

OPERATOR _____

LOCATION OF WELL: COUNTY _____

LEASE _____

feet from south/north line of section _____

WELL NUMBER _____

feet from east/west line of section _____

FIELD _____

SECTION _____ TWP _____ RG _____

NUMBER OF ACRES ATTRIBUTABLE TO WELL _____

IS SECTION REGULAR or IRREGULAR



QTR/QTR/QTR OF ACREAGE _____

IF SECTION IS IRREGULAR, LOCATE WELL FROM NEAREST CORNER BOUNDARY

Section corner used: NE NW SE SW

PLAT

(Show location of the well and shade attributable acreage for prorated or spaced wells.)
(Show footage to the nearest lease or unit boundary line.)

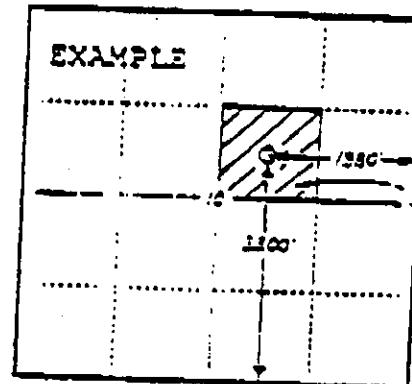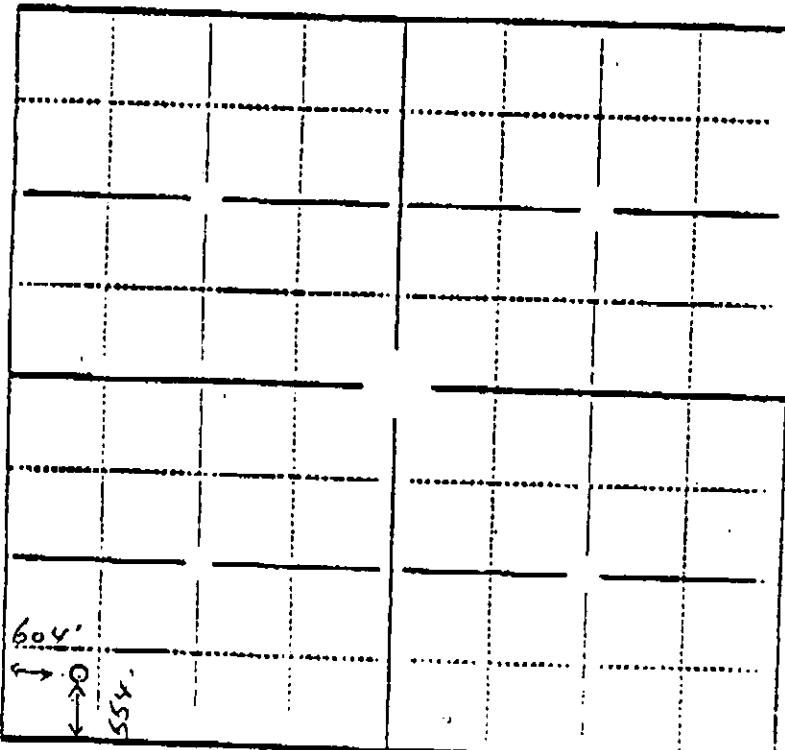

1/16
ACRES

SEWARD CO.

In plotting the proposed location of the well you must show:

- 1) The manner in which you are using the depicted plat by identifying section lines, i.e., 1 section, 1 section with 8 surrounding sections, 4 sections, etc.;
- 2) the distance of the proposed drilling location from the section's south/north and east/west lines; and
- 3) the distance to the nearest lease or unit boundary line.