


STATE OF KANSAS
STATE CORPORATION COMMISSION

15-097-00189-0000
WELL PLUGGING RECORD

Give All Information Completely
Make Required Affidavit
Mail or Deliver Report to:
Conservation Division
State Corporation Commission
800 Bitting Building
Wichita, Kansas

Kiowa County. Sec. 4 Twp. 30S Rge. 16 (E) W (W)

Location as "NE/CNW $\frac{1}{4}$ /SW $\frac{1}{4}$ " or footage from lines SW SW NW
Lease Owner Louis R. Travis
Lease Name Goldie Millar Well No. 1
Office Address 110 Midco Building Tulsa, Oklahoma
Character of Well (completed as Oil, Gas or Dry Hole) Dry Hole
Date well completed May 27 19 51
Application for plugging filed May 27 19 51
Application for plugging approved May 27 19 51
Plugging commenced May 27 19 51
Plugging completed May 27 19 51
Reason for abandonment of well or producing formation Dry Hole

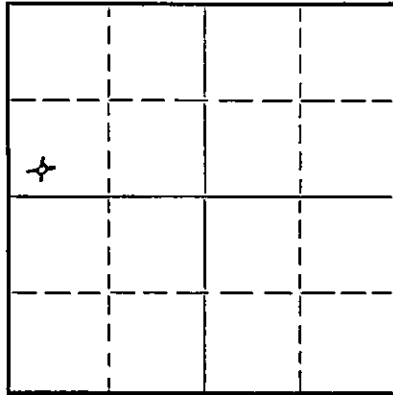

Locate well correctly on above
Section Plat

If a producing well is abandoned, date of last production 19...
Was permission obtained from the Conservation Division or its agents before plugging was com-
menced? Yes

Name of Conservation Agent who supervised plugging of this well Mr. Rives Great Bend, Kansas
Producing formation Depth to top Bottom Total Depth of Well 4973 Feet
Show depth and thickness of all water, oil and gas formations.

OIL, GAS OR WATER RECORDS

CASING RECORD

Formation	Content	From	To	Size	Put In	Pulled Out
		0	478'	8 5/8"	478'	None

Describe in detail the manner in which the well was plugged, indicating where the mud fluid was placed and the method or methods used in introducing it into the hole. If cement or other plugs were used, state the character of same and depth placed, from feet to feet for each plug set.

4972' - 251 $\frac{1}{2}$ ' - Heavy Rotary Mud
251 $\frac{1}{2}$ ' - 250' - Wooden Plug
250' - 204' - 15 sacks cement
204' - 36 $\frac{1}{2}$ ' - Heavy Rotary Mud
36 $\frac{1}{2}$ ' - 35' - Wooden Plug
35' - 6' - 10 sacks cement and 1/2 sack hulls
6' - Surface - Cellar

STATE CORPORATION COMMISSION
JUN 1 6-1-51
RECEIVED
DIVISION OF CONSERVATION

(If additional description is necessary, use BACK of this sheet)
Correspondence regarding this well should be addressed to Louis R. Travis
Address 110 Midco Building Tulsa, Oklahoma

STATE OF Kansas, COUNTY OF Barton, ss.
Glenn W. Peel (employee of owner) or (~~owner~~) of the above-described well,
being first duly sworn on oath, says: That I have knowledge of the facts, statements, and matters herein contained and the log of the above-described well as filed and that the same are true and correct. So help me God. GLENN W. PEEL
(Signature) BY: [Signature]
P. O. Box 359, Hoisington, Kansas (Address)

SUBSCRIBED AND SWORN to before me this 29th day of May, 1951
[Signature] Notary Public.

My commission expires June 4, 1951 28-5091-a 8-50-10M

PLUGGING
FILE SEC 4 T 30 R 16
BOOK PAGE 84 LINE 13

15-097-00189-0000

DRILLER'S LOG

Company: Louis R. Travis
Farm: Goldie Millar Well No: 1
Total Depth: 4973'
Comm: 5-6-51 Comp: 5-27-51
Contractor: Glenn W. Peel
Casing: 8 5/8" 478' cem.

SW SW NW
Sec. 4 Twp. 30S Rge. 16W
County: Kiowa,
Kansas
Elevation:
Production: Dry

Figures below indicate bottom of formations

Red Rock	0 -	74
Surface Clay & Shale		140
Sand Streaks		280
Shale streaks, Gyp Rock		405
Hard Shale & Gyp Rock		490
Shale & Shells		745
Anhydrite		790
Shale & Shells		1910
Lime Broken		2050
Lime & Shale		2105
Lime		2160
Lime & Shale streaks		2265
Shale		2326
Sandy Lime		2352
Lime		2370
Lime w/Shale streaks		2460
Lime		2565
Lime & Shale		2650
Broken Lime & Shale		2780
Lime & Shale		3225
Shale & Lime		3425
Broken Lime		3530
Lime		3715
Lime & Shale		3790
Lime		4555
Cherty Lime		4610
Lime		4710
Cherty Lime		4785
Lime		4972
Total Depth		4973

This is to certify that the above information is, to the best of our knowledge, true and correct.

GLENN W. PEEL

BY: *[Signature]*

SUBSCRIBED AND SWORN to before me this 29th day of May, 1951.

My commission expires June 4, 1951 *[Signature]*
Notary Public

PLUGGING
SEC 4 T 30R 16W
84 LIME 73