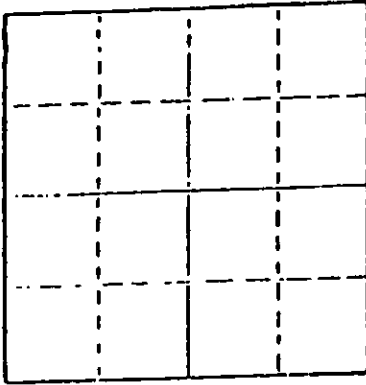


STATE OF KANSAS
STATE CORPORATION COMMISSION

WELL PLUGGING RECORD

Give All Information Completely
Make Required Affidavit
Mail or Deliver Report to
Conservation Division
State Corporation Comm.
245 North Water
Wichita, KS 67202

Locate well correctly on above
Section Plot

Lane _____ County. Sec. 7 Twp. 17S Rge. 28W E/W
Location as "NE/CNW/SW" or footage from lines _____
NW NW NE

Lease Owner Cincris Energy Company, Inc.
Lease Name Terwilliger Prospect Well No. _____
Office Address 625 Washington, Great Bend, Ks 67530
Character of Well (Completed as Oil, Gas or Dry Hole) _____

Dry
Date Well completed 12-31 1985
Application for plugging filed 12-30 1985
Application for plugging approved 12-31 1985
Plugging commenced 12-31 1985
Plugging completed 12-31 1985
Reason for abandonment of well or producing formation _____

Dry
If a producing well is abandoned, date of last production 19

Was permission obtained from the Conservation Division or
its agents before plugging was commenced? Yes

Name of Conservation Agent who supervised plugging of this well _____
Producing formation _____ Depth to top _____ Bottom _____ Total Depth of Well 4225
Show depth and thickness of all water, oil and gas formations.

OIL, GAS OR WATER RECORDS

CASING RECORD

FORMATION	CONTENT	FROM	TO	SIZE	PUT IN	PULLED OUT
		0	298	8 5/8		

Describe in detail the manner in which the well was plugged, indicating where the mud fluid
was placed and the method or methods used in introducing it into the hold. If cement or other
plugs were used, state the character of same and depth placed, from _____ feet to
_____ feet for each plug set. Plugged: 50 sacks @ 2190

80 sacks @ 1290

40 sacks @ 330

Mud up to 40 - 10 sacks to base of cellar

10 sacks rathole; 10 sacks mousehole.

Cemented by Allied

Completed @ 1:30AM 12-31-85

(If additional description is necessary, use BACK of this sheet)

Name of Plugging Contractor DaMac Drilling Inc.

STATE OF Kansas COUNTY OF Barton, ss.
Martha J McKown (employee of owner) or (owner or operator)
of the above-described well, being first duly sworn on oath, says: That I have knowledge of
the facts, statements, and matters herein contained and the log of the above-described well
as filed and that the same are true and correct. So help me God.

(Signature) Martha J. McKownBox 1164, Great Bend, Ks 67530

(Address)

SUBSCRIBED AND SWORN TO before me this 31 day of December, 1985Carmel Aschew

Notary Public.

My comm. expires

5-9-87RECEIVED
STATE CORPORATION COMMISSIONJAN 24 1986
1-24-86
CONSERVATION DIVISION

CARD MUST BE TYPED

State of Kansas
NOTICE OF INTENTION TO DRILL
(see rules on reverse side)

CARD MUST BE SIGNED

Starting Date: October 1, 1985
month day year

API Number 15-101-21,213-0000

OPERATOR: License # 9247
Name Cincris Energy Company, Inc.
Address 625 S. Washington
City/State/Zip Great Bend, Kansas 67530
Contact Person Bill Riley
Phone 316 792-8278

NW. NW. NE Sec. 7. Twp 17. S. Rge 28. ☐ East
(location) ☒ West

4950 Ft North from Southeast Corner of Section
2310 Ft West from Southeast Corner of Section
(Note: Locate well on Section Plat on reverse side)

Nearest lease or unit boundary line 330 feet
County Lane
Lease Name Terwilliger Well # 1
Domestic well within 330 feet: ☐ yes ☒ no
Municipal well within one mile: ☐ yes ☒ no

Well Drilled For: Well Class: Type Equipment:
☒ Oil ☐ Swd ☐ Infield ☒ Mud Rotary
☐ Gas ☐ Inj ☒ Pool Ext. ☐ Air Rotary
☐ OWWO ☐ Expl ☐ Wildcat ☐ Cable

Depth to Bottom of fresh water 200 feet
Lowest usable water formation DAKOTA
Depth to Bottom of usable water 1000 ~ 1100 feet
Surface pipe by Alternate: ☐ 1 ☒ 2 ☐ 3
Surface pipe to be set 270 feet
Conductor pipe if any required N/A feet
Ground surface elevation N/A feet MSL

If OWWO: old well info as follows:
Operator Box 1164
Well Name Great Bend, KS 67530
Comp Date 4600 Old Total Depth 4600 feet
Projected Total Depth 4600 feet
Projected Formation at TD Miss
Expected Producing Formations LKC

This Authorization Expires 2-19-86
Approved By PCA 8-19-85

that we will comply with K.S.A. 55-101, et seq., plus eventually plugging hole to K.C.C. specifications.

8-8-85 Signature of Operator or Agent William V. Riley Title President

Form C-1 4/84

Spud 12-23-85 Set 270'

will call back 12-26 or 12-27 for plugging orders.

PUSHER: John Crowe
TD 4225 FORMATION MISS
SURFACE PIPE 8 3/8 @ 298
ANHYDRITE 2190 - ELEVATION 2781
STARTING TIME & DATE _____
COMPLETION TIME & DATE _____
1st PLUG @ 2190 FT. W/ SD SX
2nd PLUG @ 1290 FT. W/ 80 SX
3rd PLUG @ 330 FT. W/ 40SX SX
4th PLUG @ 40-50 FT. W/ 10 SX
RAT HOLE CIRCULATION W/ 10 SX
MOUSE HOLE CIRCULATION W/ 10 SX
WATER SUPPLY WELL PLUGGED W/ W.W. SX
TECHNICIAN SD will be plugged -
cont. U D

STATE CORPORATION COMMISSION

JAN 13 1986

CONSERVATION DIVISION
Wichita, Kansas