


15-101-20050-0000

STATE OF KANSAS
STATE CORPORATION COMMISSION

Form CP-4

Give All Information Completely
Make Required Affidavit
Mail or Deliver Report to:
Conservation Division
State Corporation Commission
P. O. Box 17027
Wichita, Kansas 67217
NORTH

WELL PLUGGING RECORD

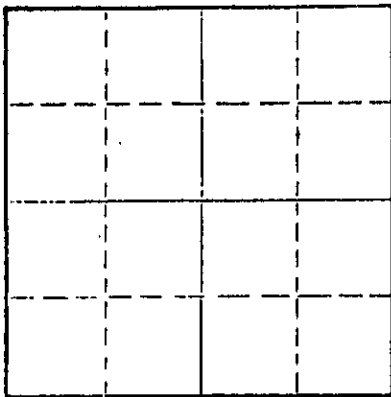

Locate well correctly on above
Section Plat

Lane _____ County, Sec. 8 Twp. 17S. Rge. 28W (E) _____ (W)

Location as "NE/CNW/SE/SW" or footage from lines _____ NE SW
Lease Owner Mull Drilling Company, Inc.

Lease Name Stover Well No. 1

Office Address 415 Page Court, 220 W. Douglas, Wichita, Kansas 67202

Character of Well (completed as Oil, Gas or Dry Hole) Dry Hole

Date well completed 2-26-73 19

Application for plugging filed 2-25-73 19

Application for plugging approved 2-25-73 19

Plugging commenced 2-25-73 19

Plugging completed 2-26-73 19

Reason for abandonment of well or producing formation
commercial quantities of oil not found

If a producing well is abandoned, date of last production _____ 19

Was permission obtained from the Conservation Division or its agents before plugging was commenced? yes

Name of Conservation Agent who supervised plugging of this well W. L. Nichols - Moreland, Kansas

Producing formation _____ Depth to top _____ Bottom _____ Total Depth of Well 4640 Feet

Show depth and thickness of all water, oil and gas formations.

OIL, GAS OR WATER RECORDS

CASING RECORD

FORMATION	CONTENT	FROM	TO	SIZE	PUT IN	PULLED OUT
				8 5/8"	244'	

Describe in detail the manner in which the well was plugged, indicating where the mud fluid was placed and the method or methods used in introducing it into the hole. If cement or other plugs were used, state the character of same and depth placed, from _____ feet to _____ feet for each plug set.

110 cu. ft. cement at 975'
30 cu. ft. cement at 275'
10 cu. ft. cement at 40'

RECEIVED
STATE CORPORATION COMMISSION
MAR 2 - 73
CONSERVATION DIVISION
Wichita, Kansas

(If additional description is necessary, use BACK of this sheet)
Name of Plugging Contractor Rains & Williamson Oil Co., Inc.
Address 435 Page Court, 220 W. Douglas, Wichita, Kansas 67202

STATE OF KANSAS, COUNTY OF SEDGWICK, ss.
Wilson Rains, President of Rains & Williamson Oil Co., Inc. (employee of owner) or (owner or operator) of the above-described well, being first duly sworn on oath, says: That I have knowledge of the facts, statements, and matters herein contained and the log of the above-described well as filed and that the same are true and correct. So help me God.

(Signature) Wilson Rains
435 Page Court, 220 W. Douglas, Wichita, Kansas 67202
(Address)

SUBSCRIBED AND SWORN to before me this 28th day of February, 1973

My commission expires October 4, 1975
Juanita M. Green Notary Public.




WELL LOG

15101-20050-0000

COMPANY Mull Drilling Company, Inc.
 FARM Stover NO. 1
 RIG. NO. 4
 TOTAL DEPTH 4640
 COMM. 2-15-73 COMP. 2-26-73
 CONTRACTOR Rains & Williamson Oil Co., Inc.

SEC. 8 T. 17S R. 28W
 LOC. NE SW

COUNTY Lane
 KANSAS

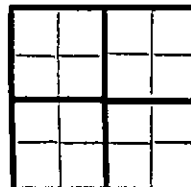

CASING
 20 10
 15 8 5/8" @ 244' w/ 175 sx. common, 2% gel, 3%cc
 12 6
 13 5

PRODUCTION D & A

FIGURES INDICATE BOTTOM OF FORMATIONS

Clay and Sand	185
Shale	735
Sand	870
Shale	925
Shale and Red Bed	1455
Shale and Sand	2165
Anhydrite	2195
Shale and Shells	2485
Shale and Lime	2725
Lime and Shale	2935
Lime	3060
Lime and Shale	3975
Lime	4640
<u>Rotary Total Depth</u>	<u>4640</u>

RECEIVED
 STATE CORPORATION COMMISSION
 MAR 2 1973
 CONSERVATION DIVISION
 Wichita, Kansas

State of Kansas
 County of Sedgwick } ss:

I, Wilson Rains, President of the Rains & Williamson Oil Co., Inc. COMPANY

upon oath state that the above and foregoing is a true and correct copy of the log of the Stover #1 well.

Wilson Rains
 Wilson Rains



Subscribed and sworn to before me this 28th day of February 19 73

My Commission Expires: October 4, 1975

Juanita M. Green
 NOTARY PUBLIC
 Juanita M. Green