

STATE OF KANSAS  
STATE CORPORATION COMMISSION

Give All Information Completely  
Make Required Affidavit  
Mail or Deliver Report to:  
Conservation Division  
State Corporation Commission  
211 No. Broadway  
Wichita, Kansas

15-101-00041-0000  
WELL PLUGGING RECORD

Lane \_\_\_\_\_ County, Sec. 9 Twp. 17S Rge. 28 (X) (W)

Location as "NE/CNW/SW" or footage from lines C NE SW NE

Lease Owner Helmerich & Payne, Inc.

Lease Name GRUSING Well No. 1

Office Address Box 558, Garden City, Kansas

Character of Well (completed as Oil, Gas or Dry Hole) Dry Hole

Date well completed 8 November 1962 19

Application for plugging filed 8 November 1962 19

Application for plugging approved 8 November 1962 19

Plugging commenced 8 November 1962 19


Plugging completed 8 November 1962 19

Reason for abandonment of well or producing formation Dry Hole

If a producing well is abandoned, date of last production - 19

Was permission obtained from the Conservation Division or its agents before plugging was commenced? Yes

NORTH

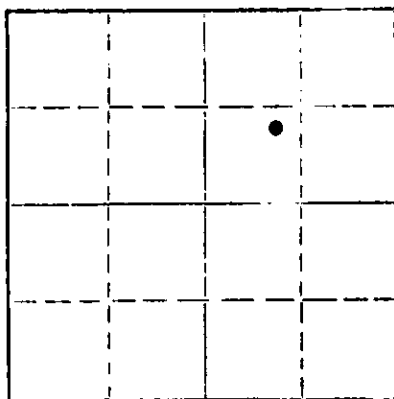

Locate well correctly on above  
Section Plat

Name of Conservation Agent who supervised plugging of this well Eldon Petty Hays, Kansas

Producing formation - Depth to top - Bottom - Total Depth of Well 4663 Feet

Show depth and thickness of all water, oil and gas formations.

OIL, GAS OR WATER RECORDS

CASING RECORD

FORMATION	CONTENT	FROM	TO	SIZE	PUT IN	PULLED OUT
		0	318	8-5/8"	318	None

Describe in detail the manner in which the well was plugged, indicating where the mud fluid was placed and the method or methods used in introducing it into the hole. If cement or other plugs were used, state the character of same and depth placed, from \_\_\_\_\_ feet to \_\_\_\_\_ feet for each plug set.

4663 to 660 Heavy Rotary Mud

660 to 600 20 sacks pozmix cement

600 to 240 Heavy Rotary Mud

240 to 180 Wiper Plug & 20 sacks pozmix cement

180 to 35 Heavy Rotary Mud

35 to 4 Wiper Plug & 10 sacks Pozmix cement

4 to 0 Cellar

Plugging Completed 8 November 1962 5:00 AM

(If additional description is necessary, use BACK of this sheet)

Name of Plugging Contractor Helmerich & Payne, Inc.

Address First National Bldg, Tulsa, Okla.

STATE OF Kansas, COUNTY OF Finney, ss.

T. E. Mort

(employee of owner) or (conservation agent)

well, being first duly sworn on oath, says: That I have knowledge of the facts, statements, and matters herein contained and the log of the above-described well as filed and that the same are true and correct. So help me God.

(Signature)

T. E. Mort

Box 558, Garden City, Kansas

(Address)

SUBSCRIBED AND SWORN to before me this 9 day of November, 19 62

My commission expires July 1964

Robert N. Boyd

Notary Public.

Grusing No. 1

Helmerich &amp; Payne, Inc.

Section 9-17S-28W

Lane County, Kansas

Commenced: 10-26-62

Completed: 11-8-62

Casing Record:

15 Joints 8-5/8" Csg. w/200 sxs. @ 320'

D&amp;A

	<u>FROM</u>	<u>TO</u>
Surface	0	458
Shale	458	1980
Shale & Anhydrite	1980	2550
Shale	2550	2764
Shale & Lime	2764	2939
Lime & Shale	2939	3190
Shale & Lime	3190	3388
Lime & Shale	3388	3434
Shale & Lime	3434	3574
Lime & Shale	3574	4174
Lime	4174	4266
Lime & Shale	4266	4567
Lime, Shale & Chert	4567	4633
Lime & Dolomite	4633	4660
<u>TOTAL DEPTH</u>		<u>4660</u>

DEC 20 1962

STATE OF OKLAHOMA )  
 ) SS  
 County of Tulsa )

I hereby affirm that the above and foregoing is a true and correct copy of the log of the  
 Grusing #1 well, located in Section 9-17S-28W, Lane County, Kansas.

HELMERICH &amp; PAYNE, INC.

*Lee Daniel*  
 Vice President

Subscribed and sworn to before me a Notary Public this 5th day of December, 1962.

*Margaret Bailey*  
 Notary Public

My commission expires: March 30, 1964.