


STATE OF KANSAS
STATE CORPORATION COMMISSION

Give All Information Completely
Make Required Affidavit
Mail or Deliver Report to:
Conservation Division
State Corporation Commission
800 Bittig Building
Wichita, Kansas

WELL PLUGGING RECORD

15-169-0047-00-00

NORTH

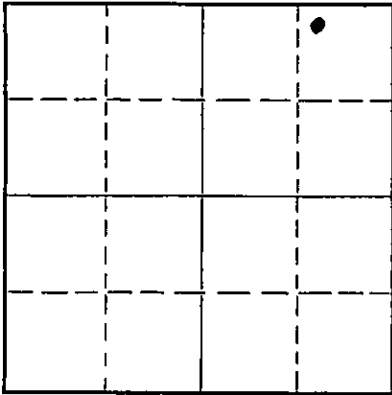

Locate well correctly on above Section Plat

Saline County. Sec. 30 Twp. 15S Rge. 3 (E) (W)
Location as "NE/CNW $\frac{1}{4}$ SW $\frac{1}{4}$ " or footage from lines E 1/2 NE 1/4
Lease Owner Max Gerkin
Lease Name Larson Well No. 1
Office Address 12th & 1st St., Sioux Falls, South Dakota
Character of Well (completed as Oil, Gas or Dry Hole) dry hole
Date well completed November 28, 1950
Application for plugging filed November 28, 1950
Application for plugging approved November 28, 1950
Plugging commenced November 28, 1950
Plugging completed November 28, 1950
Reason for abandonment of well or producing formation dry hole

If a producing well is abandoned, date of last production 19...
Was permission obtained from the Conservation Division or its agents before plugging was commenced? YES

Name of Conservation Agent who supervised plugging of this well Ruel Durkee
Producing formation Depth to top Bottom Total Depth of Well 3500 Feet
Show depth and thickness of all water, oil and gas formations.


OIL, GAS OR WATER RECORDS

CASING RECORD

Formation	Content	From	To	Size	Put In	Pulled Out
Sand	Water	39	51	8 5/8"	310'	0

Describe in detail the manner in which the well was plugged, indicating where the mud fluid was placed and the method or methods used in introducing it into the hole. If cement or other plugs were used, state the character of same and depth placed, from feet to feet for each plug set.

Circulated heavy mud on bottom and one-half way out. Pushed wooden plug to 155' and rock enough to form solid bridge to hold weight of drill pipe. Run 15 sacks cement here. Filled hole to 25' and bridged. Run 5 sacks cement, filling hole to cellar floor.

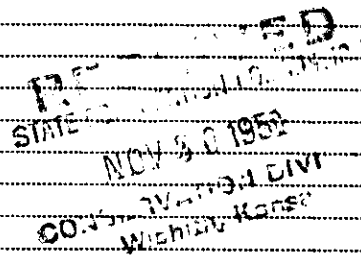

(If additional description is necessary, use BACK of this sheet)

Correspondence regarding this well should be addressed to Max Gerkin
Address 12th & 1st Streets, Sioux Falls, South Dakota

STATE OF Kansas COUNTY OF McPherson ss.
Herbert Rhoton (employee of owner) of the above-described well,
being first duly sworn on oath, says: That I have knowledge of the facts, statements, and matters herein contained and the log of the above-described well as filed and that the same are true and correct. So help me God.

(Signature) Herbert Rhoton

Box 620, McPherson, Kansas (Address)

SUBSCRIBED AND SWORN to before me this 29th day of November, 1950

My commission expires 5-6-1953 Notary Public.

PLUGGING
FILE SEC 30 T 15 R 3W
BOOK PAGE 46 LINE 3

15-169-00047-00-00

ROTARY DRILLERS' LOG

Max Gerkin, Operator
12th & 1st Streets
Sioux Falls, South Dakota

Elevation:
Laughlin-Simmons 1280 G.L.
1282 D.F.
1284 K.B.

Larson # 1

"CASING RECORD"

C. N. 1/4 NE 1/4 NE 1/4
Sec. 30-15S-3W
Saline County, Kansas

8 5/8" - 310', cement 250 sacks.
cement circulated.

Well Commenced: 11-14-50
Well Completed: 11-28-50

Contractor: E. K. Carey, Contractor (Rig #2) Box 620, McPherson, Kansas.
Geologist: Donald Roy Smith, 5206 East Central, Wichita, Kansas.

Figures Indicate Bottom of Formation K.B.

Rotary Table, Base & Cellar	8	Line and Shale	2560
Clay	20	Shale	2625
Shale	39	Shale and Lime	2775
Sand	51	Shale	2843
Shale	100	Lime	3160
Shale and Shells	260	Shale	3240
Shells and Lime	310	Red Bed	3260
Lime and Shale	965	Shale	3277
Shale and Shells	1265	Red Rock	3288
Shale and Lime	1530	Shale	3294
Lime and Shale	2091	Lime	3325
Shale and Shells	2220	Shale	3391
Lime	2360	Lime	3500 T.D.

Geologist Tops:

Mississippi Lime	2836 (-1552)	Maquoketa Shale	3224 (-2040)
Kinderhook Shale	3172 (-1888)	" Dolemite	3391 (-2107)
Misener Sand	3295 (-2011)	Viola	3449 (-2165)
Hunton	3298 (-2014)	" Dolemite	3463
		Total Depth	3500 (-2216)

Drill Stem Test:

3391'-95' Open 1 hr. Weak blow first 11 minutes. Recovered 30' slightly oil stained mud. 10 min. B.H.P. - 0.

PLUGGING

FILE SEC 30 T 15 R 3W
BOOK PAGE 46 LINE 3

E. K. CAREY, CONTRACTOR
Herbert Rhoton
By Herbert Rhoton, Supt.

STATE OF KANSAS
COUNTY OF MCPHERSON)

On this 29th day of November, 1950, before me, A. J. Darrah
a Notary Public, in and for said County and State, personally appeared
Herbert Rhoton, to me personally known to be the identical person named in
and who executed the foregoing instrument, and acknowledged that he executed
and delivered the same as his free and voluntary act & deed, for the purpose
and consideration therein set forth.

My Commission Expires: 5-6-1953

A. J. Darrah
Notary Public