


STATE OF KANSAS
STATE CORPORATION COMMISSION

Give All Information Completely
Make Required Affidavit
Mail or Deliver Report to:
Conservation Division
State Corporation Commission
212 North Market, Insurance Bldg.
Wichita, Kansas

15-169-19091-00-00
WELL PLUGGING RECORD

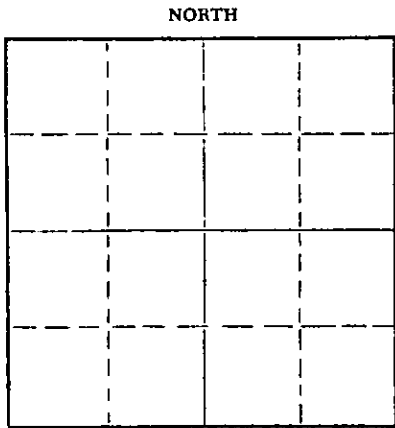

Locate well correctly on above Section Plat

Location as "NE/CNWxSWx" or footage from lines. Saline County. Sec. 30 Twp. 15 Rge. 3 (E) W (W)
Lease Owner Currier & Keys
Lease Name Swenson Well No. 1
Office Address Salina, Kansas
Character of Well (completed as Oil, Gas or Dry Hole) _____
Date well completed _____ 19____
Application for plugging filed _____ 19____
Application for plugging approved _____ 19____
Plugging commenced 11-28-60 _____ 19____
Plugging completed 11-30-60 _____ 19____
Reason for abandonment of well or producing formation Depleted.

If a producing well is abandoned, date of last production _____ 19____
Was permission obtained from the Conservation Division or its agents before plugging was commenced? yes

Name of Conservation Agent who supervised plugging of this well Gilbert Toman
Producing formation _____ Depth to top _____ Bottom _____ Total Depth of Well 3404 Feet
Show depth and thickness of all water, oil and gas formations.

OIL, GAS OR WATER RECORDS				CASING RECORD		
FORMATION	CONTENT	FROM	TO	SIZE	PUT IN	PULLED OUT
				8-5/8"	330'	None
				5-2/2"	3400'	2844'

Describe in detail the manner in which the well was plugged, indicating where the mud fluid was placed and the method or methods used in introducing it into the hole. If cement or other plugs were used, state the character of same and depth placed, from _____ feet to _____ feet for each plug set.

Checked hole to 3404' and found it clear.
Ran sand from 3404' to 3390' and dumped 5 sacks of cement @ 3390' with dump bailer.
Pulled 5 1/2" casing. Mudded hole to 210', set 10' rock bridge to 200' and ran 20 sacks of cement @ 200'. Mudded hole to 40', set 10' rock bridge to 30' and ran 10 sacks of cement to base of cellar.

PLUGGING COMPLETE.

JAN 4 1961
CONSERVATION DIVISION
Wichita, Kansas

(If additional description is necessary, use BACK of this sheet)
Name of Plugging Contractor Knight Casing Pulling Company
Address Chase, Kansas

STATE OF Kansas COUNTY OF Rice, ss.
Noel Knight (employee of owner) or (~~owner~~) of the above-described well, being first duly sworn on oath, says: That I have knowledge of the facts, statements, and matters herein contained and the log of the above-described well as filed and that the same are true and correct. So help me God.

(Signature) Noel J. Knight
Chase, Kansas
(Address)

SUBSCRIBED AND SWORN TO before me this 2nd day of December, 1960

My commission expires May 20, 1964
Melton J. Volin Notary Public.



