

15-169-00473-00-00


STATE OF KANSAS
STATE CORPORATION COMMISSION

Form CP-4

Give All Information Completely
Make Required Affidavit
Mail or Deliver Report to:
Conservation Division
State Corporation Commission
212 No. Market
Wichita, Kansas

WELL PLUGGING RECORD

NORTH

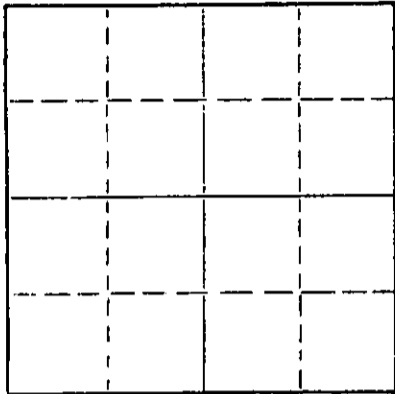

Locate well correctly on above
Section Plat

Saline County, S24 Twp. 15 Rge. 3 W (E) (W)
Location as "NE/CNW/SW" or footage from lines C SE NW

Lease Owner Cal Jones

Lease Name Carlin Well No. 2

Office Address Br 5 Canton, Kansas

Character of Well (completed as Oil, Gas or Dry Hole) oil

Date well completed II-24-61

Application for plugging filed 5-3 1969

Application for plugging approved 5-5 1969

Plugging commenced 5-28 1969

Plugging completed 6-2 1969

Reason for abandonment of well or producing formation

If a producing well is abandoned, date of last production 19

Was permission obtained from the Conservation Division or its agents before plugging was commenced? Yes

Name of Conservation Agent who supervised plugging of this well Gilbert Toman

Producing formation Depth to top Bottom Total Depth of Well 3467' Feet

Show depth and thickness of all water, oil and gas formations.

OIL, GAS OR WATER RECORDS

CASING RECORD

FORMATION	CONTENT	FROM	TO	SIZE	PUT IN	PULLED OUT
				5 1/2"		2,751'

Describe in detail the manner in which the well was plugged, indicating where the mud fluid was placed and the method or methods used in introducing it into the hole. If cement or other plugs were used, state the character of same and depth placed, from feet to feet for each plug set.

Plugged off bottom of hole with sand.
Sand from 3467' to 3400'. Dumped 5 sx of cement. Mudded hole to 260. Made 10' of rock bridge. Dumped 25 sx of cement. Mudded hole to 40'. Made 10' of rock bridge. Dumped 10 sx of cement, filling to the bottom of the collar.

RECEIVED
STATE CORPORATION COMMISSION
JUN 5 1969
CONSERVATION DIVISION
Wichita, Kansas

(If additional description is necessary, use BACK of this sheet)

Name of Plugging Contractor Art Lamb Casing Pulling Co.
Address 2809 King St. Hutchinson Kansas 67501

STATE OF Kansas, COUNTY OF Reno, ss.
Art Lamb (employee of owner) or (owner or operator) of the above-described well, being first duly sworn on oath, says: That I have knowledge of the facts, statements, and matters herein contained and the log of the above-described well as filed and that the same are true and correct. So help me God.

(Signature) Art Lamb
2809 King St. Hutchinson, Kansas
(Address)

SUBSCRIBED AND SWORN to before me this 3rd day of June, 1969

Judy Lamb
Notary Public.

My commission expires January 5, 1970

WELL LOG BUREAU—KANSAS GEOLOGICAL SOCIETY
508 East Murdock, Wichita, Kansas


15-169-00473-00-00
COPY

Company- CAL JONES
Farm- Carlin No. 2

SEC. 24 T. 15 R. 3W
C SE NW

Total Depth. 3471'
Comm. 11-15-61 Comp. 11-24-61
Shot or Treated.
Contractor. Melland Drlg. Co.
Issued. 4-7-62

County Saline
KANSAS

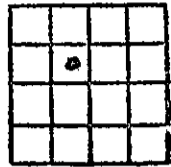

CASING:
8 5/8" 278' cem w/200 sx.
5 1/2" 3467'

Elevation. 1269' RB

Production, 25 BOPD

Figures Indicate Bottom of Formations.

surface soil & clay	30
sand	65
shale, clay & shells	190
Anhydrite	230
lime	278
Anhydrite	345
lime & shale	990
shale	1350
shale & shells	1600
lime & shale	2460
shale & shells	2703
Mississippi lime	2960
shale	3100
lime	3323
lime & shale	3373
sand & shale	3421 RTD
sand & shale	3471
Total Depth	

TOPS: SCOUT	
Mississippi	2703
Maquoketa Dolomite	3250
Viola	3288
Simpson	3289
Simpson Sand	3412
Arbuckle	3466

RECEIVED
STATE CORPORATION COMMISSION
MAY 5 1969
CONSERVATION DIVISION
Wichita, Kansas