


WELL PLUGGING RECORD

Give All Information Completely
Make Required Affidavit
Mail or Deliver Report to:
Conservation Division
State Corporation Commission
211 No. Broadway
Wichita, Kansas

Saline County, Sec. 24 Twp. 15 Rge. (E) 3 (W)

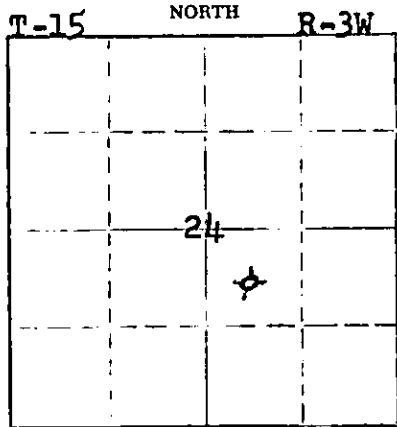

Locate well correctly on above Section Plat

Location as "NE/CNWxSWx" or footage from lines C NW SE
Lease Owner Morrison Producing Company
Lease Name Jenney Well No. 1
Office Address Box 712, El Dorado, Kansas
Character of Well (completed as Oil, Gas or Dry Hole) Dry Hole
Date well completed 6-26-1961
Application for plugging filed 6-26-1961
Application for plugging approved 6-26-1961
Plugging commenced 6-26-1961
Plugging completed 6-26-1961
Reason for abandonment of well or producing formation dry

If a producing well is abandoned, date of last production _____ 19____
Was permission obtained from the Conservation Division or its agents before plugging was commenced? Yes

Name of Conservation Agent who supervised plugging of this well Gilbert Toman
Producing formation _____ Depth to top _____ Bottom _____ Total Depth of Well 3378 Feet
Show depth and thickness of all water, oil and gas formations.

OIL, GAS OR WATER RECORDS

CASING RECORD

FORMATION	CONTENT	FROM	TO	SIZE	PUT IN	PULLED OUT
				8 5/8"	250'	None

Describe in detail the manner in which the well was plugged, indicating where the mud fluid was placed and the method or methods used in introducing it into the hole. If cement or other plugs were used, state the character of same and depth placed, from _____ feet to _____ feet for each plug set.

Gun pits, circulate heavy mud. Mud to 245', push plug and 1/4 sack hulls and 20 sacks cement through drill pipe. Mud to 40', plug and 1/4 sack hulls and 10 sacks cement. 2 sacks cement in rathole.

RECEIVED
STATE CORPORATION COMMISSION
JUN 29 1961
CONSERVATION DIVISION
Wichita, Kansas

(If additional description is necessary, use BACK of this sheet)

Name of Plugging Contractor Donald T. Ingling
Address 615 First National Bldg., Wichita 2, Kansas

STATE OF KANSAS, COUNTY OF SEDGWICK, ss.
D. T. Ingling (employee of owner) or (owner or operator) of the above-described well, being first duly sworn on oath, says: That I have knowledge of the facts, statements, and matters herein contained and the log of the above-described well as filed and that the same are true and correct. So help me God.

(Signature) [Signature]
Wichita, Kansas (Address)

SUBSCRIBED AND SWORN TO before me this 27th day of June, 1961

My commission expires Feb. 27, 1964 [Signature] Notary Public.

WELL LOG - JENNY NO. 1

15-169-00218-00-00

Morrison Producing Company, Lease Owner

Section 24-15-3W

Donald T. Engling, Contractor

Location: C NW SE

Commenced: 6-17-61

County: Saline

Completed: 6-26-61

Production: Dry

Total Depth: 3378'

Elevation:

Casing: 8 5/8" 250' (175 sacks cement)

Figures below indicate bottom formation

40	surface clay and sand	3321	shale - Maquekota
75	sand and shale	3345	Maquekota dolomite
200	shale shells	3346	Maquekota dolomite
250	lime	3378	Viola
280	lime	3378	Total Depth
620	lime		
865	lime and shale		
990	lime and shale streaks		
1145	shale and shells		
1495	shale and shells		
1665	shale and shells		
1705	lime		
1870	lime		
2020	shale and shells		
2120	shale		
2180	lime		
2320	lime		
2450	lime and shale streaks		
2580	shale and lime		
2710	shale and lime		
2747	shale		
2790	Mississippi		
2910	lime - Mississippi		
2989	Mississippi		
2995	shale		
3075	shale		
3155	shale		
3197	shale		
3210	Hunton		
3234	lime		
3270	lime		

RECEIVED
STATE CORPORATION COMMISSION

JUN 29 1961

CONSERVATION DIVISION
Wichita, Kansas

I certify this is a true and correct copy of the above mentioned well.

D. T. Engling

STATE OF KANSAS, COUNTY OF SEDGWICK: ss

Subscribed and sworn to before me, a Notary Public, in said county and state.

M. E. Beach

My commission expires: Feb 27, 1964