


STATE OF KANSAS
STATE CORPORATION COMMISSION

15-169-00220-00-00

WELL PLUGGING RECORD

Give All Information Completely
Make Required Affidavit
Mail or Deliver Report to:
Conservation Division
State Corporation Commission
800 Blitting Building
Wichita, Kansas

NORTH

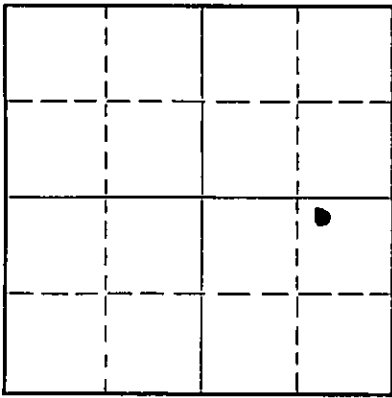

Locate well correctly on above
Section Plat

..... Saline County. Sec. 24 Twp. 15 Rge. 3 W (W)
Location as "NE/CNW $\frac{1}{4}$ SW $\frac{1}{4}$ " or footage from lines NW $\frac{1}{4}$ NE $\frac{1}{4}$
Lease Owner Loren Hallam, etal
Lease Name Nelson Well No. 1
Office Address 130 East Cloud Street, Salina, Kansas
Character of Well (completed as Oil, Gas or Dry Hole) dry hole
Date well completed November 6 1950
Application for plugging filed November 6 1950
Application for plugging approved November 6 1950
Plugging commenced November 6 1950
Plugging completed November 6 1950
Reason for abandonment of well or producing formation dry hole

If a producing well is abandoned, date of last production 19.....
Was permission obtained from the Conservation Division or its agents before plugging was commenced? yes

Name of Conservation Agent who supervised plugging of this well Ruel Durkee
Producing formation..... Depth to top..... Bottom..... Total Depth of Well 3341 Feet
Show depth and thickness of all water, oil and gas formations.

OIL, GAS OR WATER RECORDS

CASING RECORD

Formation	Content	From	To	Size	Put In	Pulled Out
Sand	Water	30	40	8 5/8	244	0

Describe in detail the manner in which the well was plugged, indicating where the mud fluid was placed and the method or methods used in introducing it into the hole. If cement or other plugs were used, state the character of same and depth placed, from..... feet to..... feet for each plug set.

Circulated heavy mud on bottom and 1/2 way out. Pushed wooden plug to 150' and built bridge of rock to hold Drill Pipe. Ran 15 sacks cement here. Filled hole to 30' with mud and bridged. Ran 6 sacks cement filling hole to cellar floor.

RECEIVED

11-8-50

(If additional description is necessary, use BACK of this sheet)

Correspondence regarding this well should be addressed to Mr. Loren Hallam
Address 130 East Cloud Street, Salina, Kansas

STATE OF Kansas, COUNTY OF McPherson, ss.
Herbert Rhoton, Acting Agent for Operator of the above-described well,
being first duly sworn on oath, says: That I have knowledge of the facts, statements, and matters herein contained and the log of the above-described well as filed and that the same are true and correct. So help me God. E. K. CAREY, CONTRACTOR

(Signature) By Herbert Rhoton
Box 620, McPherson, Kansas
(Address)

SUBSCRIBED AND SWORN to before me this 7th day of November, 1950

Peter Ansell

My commission expires June 5-1953

Notary Public.

PLUGGING 8273-s 4-50-10M
FILE SEC 24 T 15 R 13W
BOOK PAGE 41 LINE 10

15-169-00220-00-00

ROTARY DRILLERS' LOG

Loren Hallam, etal
130 East Cloud St.
Salina, Kansas

Elevation:
Laughlin-Simmons - 1266 G.L.
1269 D.F.
1271 K.B.

Nelson # 1

"CASING RECORD"

NE $\frac{1}{4}$, Sec. 24-15S-3W,
Saline County, Kansas

8 5/8" - 244' cement - 250 sacks.
cement circulated.

Well commenced: 10-25-50
Well completed D&A: 11-6-50

Contractor: E. K. Carey, Contractor (Rig #1) Box 620, McPherson, Kansas
Geologist: Don H. Smith, 5206 East Central, Wichita, Kansas.

66

Figures Indicate Bottom of Formation K.B.

Rotary Table, Base & Cellar	8	Lime	1940
Surface Soil & Clay	30	Shale and Lime	2045
Sand	40	Shale	2085
Shale and Shells	175	Lime	2580
Shale and Sand	190	Shale	2720
Lime and Shale	340	Lime	2875
Lime	385	Shale	2935
Sand	405	Lime and Chert	2972
Lime and Shale	550	Lime	3010
Lime	760	Shale	3130
Lime and Shale	900	Lime	3215
Shale and Lime	1610	Shale	3245
Lime and Shale	1665	Lime	3341
Shale and Lime	1740		T.D.

Geologist Tops:

Mississippi Lime	2713 (-1442)	Jaquoketa Dolomite	3245 (-1974)
Kinderhook Shale	2992 (-1721)	Viola	3286 (-2015)
Hunton	3128 (-1857)	Total Depth	3341 (-2070)
Jaquoketa Shale	3282 (-2011)		

The above Rotary Drillers' Log is correct and complete to the best of my knowledge.

E. K. CAREY, CONTRACTOR

NOV 15 1950
24-15-3W
41-24-60

Herbert Rhoton
By Herbert Rhoton, Supt.

STATE OF KANSAS)
COUNTY OF MCPHERSON) ss

On this 7th day of November, 1950, before me, _____
a Notary Public, in and for said County and State, personally appeared
Herbert Rhoton, to me personally known to be the identical person named
in and who executed the foregoing instrument, and acknowledged that he
executed and delivered the same as his free and voluntary act & deed, for
the purpose and consideration therein set forth.

Peter Amel

Notary Public

My Commission Expires: _____