

STATE OF KANSAS
STATE CORPORATION COMMISSION


Form CP-4

WELL PLUGGING RECORD

Give All Information Completely
Make Required Affidavit
Mail or Deliver Report to:
Conservation Division
State Corporation Commission
212 No. Market
Wichita, Kansas

Saline County. Sec. 24 Twp. 15 Rge. 3W (E) (W)
SW NW NE

Location as "NE/CNW/KSW" or footage from lines _____
Lease Owner Tom C. Brown
Lease Name Andrew Nelson Well No. 1
Office Address P. O. Box 387, Lindsborg, Kans. 67456
Character of Well (completed as Oil, Gas or Dry Hole) Oil
Date well completed Wash down 1969
Application for plugging filed November 17 1969
Application for plugging approved November 17 1969
Plugging commenced November 21 1969
Plugging completed November 24 1969
Reason for abandonment of well or producing formation Depletion

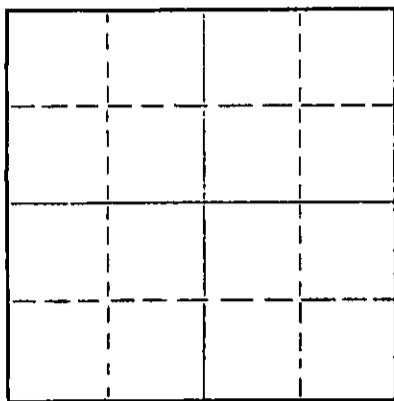

Locate well correctly on above
Section Plat

If a producing well is abandoned, date of last production October 1969
Was permission obtained from the Conservation Division or its agents before plugging was commenced? Yes

Name of Conservation Agent who supervised plugging of this well Gilbert Toman
Producing formation Magarkita Dolomite Depth to top 3245 Bottom 3285 Total Depth of Well 3321 Feet
Show depth and thickness of all water, oil and gas formations.


OIL, GAS OR WATER RECORDS

CASING RECORD

FORMATION	CONTENT	FROM	TO	SIZE	PUT IN	PULLED OUT
				<u>4 1/2 OD</u>	<u>3316</u>	<u>2703</u>

Describe in detail the manner in which the well was plugged, indicating where the mud fluid was placed and the method or methods used in introducing it into the hole. If cement or other plugs were used, state the character of same and depth placed, from _____ feet to _____ feet for each plug set.

Filled back with sand and dumped 3 sacks of cement. Shot pipe off at 2702.80". Pulled pipe and mudded hole to 240'... set 10' rock bridge and dumped 25 sacks of cement. Finished mudding hole and dumped 10 sacks of cement at top of surface.

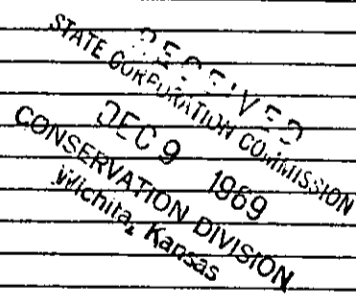

(If additional description is necessary, use BACK of this sheet)

Name of Plugging Contractor Bert Self
Address Hutchinson, Kans.

STATE OF Kans. COUNTY OF Reno, ss.
Employee (employee of owner) or (owner or operator) of the above-described

well, being first duly sworn on oath, says: That I have knowledge of the facts, statements, and matters herein contained and the log of the above-described well as filed and that the same are true and correct. So help me God.

(Signature) Bert Self
R. R. #4, Hutchinson, Kans.
(Address)

Subscribed and sworn to before me this 25th day of November, 19 69
October 18, 1973



Notary Public.

WELL LOG BUREAU—KANSAS GEOLOGICAL SOCIETY

500 East Murdock,

Wichita, Kansas

15-169-00220-00-01

Company- LOREN HALLAN et al
Farm- Nelson No. 1

SEC. 21 T. 35 N. 27 W.
SW 1/4

Total Depth. 3341
Comm. 10-25-50 Comp. 11-6-50

County Saline
Kansas

Shot or Treated.
Contractor. E. K. Carey
Issued. 3-22-52

CASING:
8 5/8" 2 1/4" cem w/ 250 sx

Elevation. 1212

Condition. dry

Figures Indicate Bottom of Formations.

cellar	8
clay	30
sand	40
shale, shells	175
shale, sand	190
lime, shale	340
lime	385
sand	405
lime, shale	550
lime	760
lime, shale	900
shale, lime	1740
lime	1940
lime, shale	2045
chalo	2085
lime	2580
shale	2720
lime	2875
shale	2935
lime, cherty	2972
lime	3010
shale	3130
lime	3215
shale	3245
lime	3341

Total Depth

Tops: Scout.	
Mississippi Lime	2713
Base Miss. Lime	2992
Munton	3128
Maquoketa Shale	3182
Maquoketa dolomite	3245
Viola	3286
Lansing	3321

RECEIVED
STATE CORPORATION COMMISSION
DEC 9 1969
CONSERVATION DIVISION
Wichita, Kansas

216.2.2.1