


Give All Information Completely  
Make Required Affidavit  
Mail or Deliver Report to:  
Conservation Division  
State Corporation Commission  
211 No. Broadway  
Wichita, Kansas

Saline County. Sec. 19 Twp. 15 Rge. 3 (E) (W)

Location as "NE/CNW/SW" or footage from lines SE of 1/2  
Lease Ow. Dicks Supply Company  
Lease Name Richter Well No. 1  
Office Address Great Bend, Kansas  
Character of Well (completed as Oil, Gas or Dry Hole)  
Date well completed 19  
Application for plugging filed 19  
Application for plugging approved 19  
Plugging commenced 12-13-62 19  
Plugging completed 12-20-62 19  
Reason for abandonment of well or producing formation Depleted.

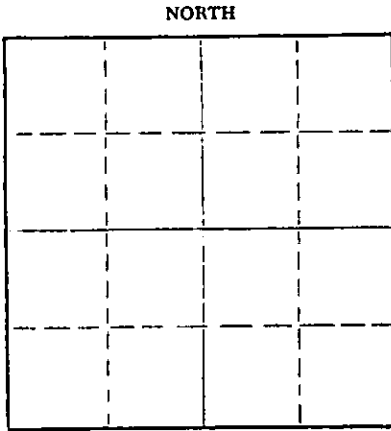

Locate well correctly on above Section Plat

If a producing well is abandoned, date of last production 19  
Was permission obtained from the Conservation Division or its agents before plugging was commenced? yes

Name of Conservation Agent who supervised plugging of this well Cecil Jones  
Producing formation \_\_\_\_\_ Depth to top \_\_\_\_\_ Bottom \_\_\_\_\_ Total Depth of Well 3391 Feet  
Show depth and thickness of all water, oil and gas formations.

OIL, GAS OR WATER RECORDS

CASING RECORD

FORMATION	CONTENT	FROM	TO	SIZE	PUT IN	PULLED OUT
				8-5/8"	300'	None
				5-1/2"	3389'	2968'

Describe in detail the manner in which the well was plugged, indicating where the mud fluid was placed and the method or methods used in introducing it into the hole. If cement or other plugs were used, state the character of same and depth placed, from \_\_\_\_\_ feet to \_\_\_\_\_ feet for each plug set.

Checked hole to 3390', sanded to 3370' and dumped 5 sacks of cement @ 3370' with dump bailer. Pulled 5" casing. Bailed fluid to 265', set rock bridge to 245' and ran 20 sacks of cement @ 245'. Mudded to 30', set rock bridge and ran 8 sacks of cement to base of cellar.

PLUGGING COMPLETE.

JAN 11 1963

(If additional description is necessary, use BACK of this sheet)

Name of Plugging Contractor KNIGHT CASING PULLING COMPANY  
Address CHASE, KANSAS

STATE OF KANSAS, COUNTY OF RICE, ss.  
Noel J. Knight (employee of owner) or (owner) of the above-described well, being first duly sworn on oath, says: That I have knowledge of the facts, statements, and matters herein contained and the log of the above-described well as filed and that the same are true and correct. So help me God.

(Signature) Noel J. Knight  
Chase, Kansas  
(Address)

SUBSCRIBED AND SWORN TO before me this 28th day of December, 1962

My commission expires May 20, 1964

Milton J. Volin  
Notary Public.

LICKS SUPPLY 15-169-00066-00-00  
 KANSAS GEOLOGICAL SOCIETY  
 KANSAS WELL LOG BUREAU - KANSAS WELL SAMPLE BUREAU  
 KANSAS GEOLOGICAL SOCIETY BUILDING  
 508 EAST MURDOCK - WICHITA, KANSAS

COMPANY **W.R. STUDNICKA ET AL**

SEC. 19 T. 15 R. 3W

FARM **Richter**

NO. **1**

LOC. **SE SE SW**

TOTAL DEPTH **3391'**


COMM. **9-26-50**

COMP. **10-9-50**

COUNTY **Saline**

SHOT OR TREATED

CONTRACTOR  
 ISSUED **8-15-59**

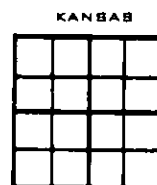

CASING

20	10	
15	8 5/8	300' <i>com Cite.</i>
12	6	
13	5 1/4	3389' <i>w/50 SKs</i>

ELEVATION **1288'**

PRODUCTION **132 BOPD & NW**

clay, rock	30
sand, gravel	38
shale	70
shale, shells	240
Anhydrite	300
lime, shale	320
shale, shells	350
lime	435
lime, shale	1165
salt, shale	1180
shale, lime	1775
lime	1940
lime, shale	2105
lime	2110
ody lime	2170
lime, shale	2250
lime	2570
lime, shale	2860
lime	3078
lime, chert	3100
lime	3152
shale, lime	3295
lime	3332
lime, shale	3380
shale	3385
lime Viola	3391
Total Depth	

FIGURES INDICATE BOTTOM OF FORMATIONS

TOPS: SCOUT	
Mississippi	2846
Kinderhook	3160
Weisner	3288
Hunton	3295
Maquokets	3322
Cherty Viola	3385

JAN 11 1963