

CARD MUST BE TYPED

State of Kansas

CARD MUST BE SIGNED

# NOTICE OF INTENTION TO DRILL

(see rules on reverse side)

Expected Spud Date..... 9 22 87  
month day year

API Number 15- 169-20,295-00-00 ✓ DA  
1520 FEL; 330 FSL SE/4 — East  
..... Sec.... 21 Twp. 16. S, Rg.... 3W.  West  
..... 330..... Ft. from South Line of Section  
..... 1520..... Ft. from East Line of Section

OPERATOR: License # 5800  
Name Homer G. Krehbiel, Sr.  
Address 1343 N. Maple  
City/State/Zip McPherson, Kansas 67460  
Contact Person Homer G. Krehbiel, Sr.  
Phone 1-241-0025

(Note: Locate well on Section Plat on reverse side)

Nearest lease or unit boundary line ..... 330..... feet  
County..... Saline.....  
Lease Name..... Rich..... Well #..... 1.....

CONTRACTOR: License # 5302  
Name Red Tiger Drilling Co.  
City/State Wichita, Kansas 67202

Ground surface elevation ..... feet MSL  
Domestic well within 330 feet: ..... yes  no  
Municipal well within one mile: ..... yes  no

Well Drilled For: Well Class: Type Equipment:  
 Oil  Storage  Infield  Mud Rotary  
 Gas  Inj  Pool Ext.  Air Rotary  
 OWWO  Expl  Wildcat  Cable

Depth to bottom of fresh water.....  
Depth to bottom of usable water.....  
Surface pipe by Alternate: 150' 13-3/8" 1 2  
Surface pipe planned to be set 460' 8.5/8"  
Conductor pipe required 150' 13-3/8"  
Projected Total Depth..... 3550..... feet  
Formation..... ARB.....

If OWWO: old well info as follows:

Operator.....  
Well Name.....  
Comp Date..... Old Total Depth.....

I certify that well will comply with K.S.A. 55-101, et seq., plus any rules promulgating here to KCC's specifications  
Date 9-17-87..... Signature of Operator or Agent *Henry A. Ough* Title.....

For KCC Use:


Conductor Pipe Required ..... feet; Minimum Surface Pipe Required ..... 200 feet per Alt. ①   
This Authorization Expires 3-17-88 Effective 9-22-87 Approved By *Feb 9-17-87*

Must be filed with the K.C.C. five (5) days prior to commencing well  
 This card void if drilling not started within six (6) months of date received by K.C.C.

Important procedures to follow:

1. Notify District office before setting surface casing.
  2. Set surface casing by circulating cement to the top.
  3. File completion forms ACO-1 with K.C.C. within 120 days of well spud date, following instructions on ACO-1, side 1, and including copies of wireline logs.
  4. Notify District office 48 hours prior to old well workover or re-entry.
  5. Prior to filing Intent, prepare a proposed plugging plan in case well is D & A, then obtain approval of plan when calling district office prior to setting surface pipe.
  6. Submit plugging report (CP-4) to K.C.C. after plugging is completed.
- Obtain an approved injection docket number before disposing of salt water.
- Notify K.C.C. within 10 days when injection commences or terminates.
9. If an alternate 2 completion, cement in the production pipe from below any usable water to surface within 120 days of spud date.

A Regular Section of Land  
 1 Mile = 5,280 Ft.

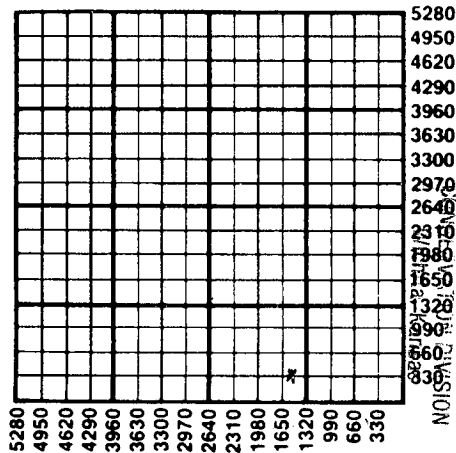

SEP 17 1987

STATE CORPORATION COMMISSION  
 RECEIVED

09-17-1987

State Corporation Commission of Kansas  
 Conservation Division  
 200 Colorado Derby Building  
 Wichita, Kansas 67202-1212  
 (316) 263-3238