


15-169-00569-00-00

STATE OF KANSAS  
STATE CORPORATION COMMISSION

Form CP-4

Give All Information Completely  
Make Required Affidavit  
Mail or Deliver Report to:  
Conservation Division  
State Corporation Commission  
P. O. Box 17027  
Wichita, Kansas 67217  
NORTH

WELL PLUGGING RECORD

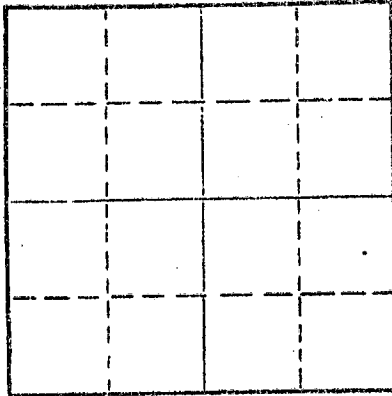

Locate well correctly on above  
Section Plat

Saline County, Sec. 5 Twp. 16 Rge. 3 (E) @ (W)  
Location as "NE/CNWKSW" or footage from lines NW SE NW  
Lease Owner Tom C. & E. Melva Brown  
Lease Name Church Property Well No. 3  
Office Address Box 387, Lindsborg, Ks 67456  
Character of Well (completed as Oil, Gas or Dry Hole) oil  
Date well completed unknown 19 74  
Application for plugging filed June 12 74 19 74  
Application for plugging approved June 13 19 74  
Plugging commenced June 28 19 74  
Plugging completed July 5 19 74  
Reason for abandonment of well or producing formation depleted

If a producing well is abandoned, date of last production 19  
Was permission obtained from the Conservation Division or its agents before plugging was commenced? yes

Name of Conservation Agent who supervised plugging of this well Mr. Gilbert Toman  
Producing formation Depth to top Bottom Total Depth of Well 3392 Feet  
Show depth and thickness of all water, oil and gas formations.

OIL, GAS OR WATER RECORDS

CASING RECORD

FORMATION	CONTENT	FROM	TO	SIZE	PUT IN	PULLED OUT
				5 1/2"	unknown	2816.90'

Describe in detail the manner in which the well was plugged, indicating where the mud fluid was placed and the method or methods used in introducing it into the hole. If cement or other plugs were used, state the character of same and depth placed, from feet to feet for each plug set.

Rig up, filled with sand to 3350' and mixed and dumped 5 sacks of cement to plug bottom.  
Dug out cellar. Put a 10' rock bridge at 200' to 190' and added 25 sacks of cement.  
Put a 10' rock bridge at 40' to 30' and added 10 sacks of cement to plug to surface.

RECEIVED  
STATE CORPORATION COMMISSION  
JUL 10 1974  
CONSERVATION DIVISION  
Wichita, Kansas

(If additional description is necessary, use BACK of this sheet)  
Name of Plugging Contractor THE BUCKEYE CORPORATION  
Address Box 1020, El Dorado, Kansas 67042

STATE OF KANSAS, COUNTY OF BUTLER, ss.  
Charles V. Cross (employee of owner) or (owner or operator) of the above-described well, being first duly sworn on oath, says: That I have knowledge of the facts, statements, and matters herein contained and the log of the above-described well as filed and that the same are true and correct. So help me God.

(Signature) *Charles V. Cross*  
Box 1020, El Dorado, Ks 67042  
(Address)

SUBSCRIBED AND SWORN to before me this 9th day of July, 1974

ISA L. FISHER  
STATE NOTARY PUBLIC  
Butler County, Ks.  
My Commission Expires  
June 30, 1975

*Isa L. Fisher*  
Notary Public.

My commission expires

15-169-00569-00-00

<u>L HOWE</u>	<u>#3</u>	<u>SALEMSBORG</u>	<u>5-16-3W</u> <u>NW SE NW</u>
		<u>CHURCH</u>	
Contr. <u>SHIELDS DRILLING</u>		<u>SALINE</u> County	
E <u>1316RB</u>	Comm. _____	Comp <u>2-18-55</u>	IP <u>25 BOPD</u>

Tops	Depth	Datum	Casing
			8" 338
			5" 3390
MAQ DOL	3390	-2074	
TD	3392	-2076	

ACID 1000: 6 BOPH

SALEMSBORG POOL

+	+	+	+
+	+	+	+

INDEPENDENT OIL & GAS SERVICE  
WICHITA, KANSAS