

15-169-00720-00-00
WELL PLUGGING RECORD

STATE OF KANSAS
STATE CORPORATION COMMISSION

Give All Information Completely
Make Required Affidavit
Mail or Deliver Report to:
Conservation Division
State Corporation Commission
800 Bitting Building
Wichita, Kansas

OR
FORMATION PLUGGING RECORD

Strike out upper line
when reporting plug-
ging off formations.

Saline County. Sec. 4 Twp. 16 Rge. 3 (E) 3 (W)

Location as "NE 1/4 NW 1/4 SW 1/4" or footage from lines. NE/4 NE/4 NE/4

Lease Owner. W.J. Sherman et al
Lease Name. Lindstrom Well No. 1

Office Address. Wichita, Kansas.

Character of Well (completed as Oil, Gas or Dry Hole) Dry Hole

Date well completed. Nov. 27. 19. 47

Application for plugging filed. " 27. 19. 47

Application for plugging approved. " 27. 19. 47


Plugging commenced. " 27. 19. 47

Plugging completed. " 27. 19. 47

Reason for abandonment of well or producing formation.

If a producing well is abandoned, date of last production. 19.

Was permission obtained from the Conservation Division or its agents before plugging was com-
menced? Yes

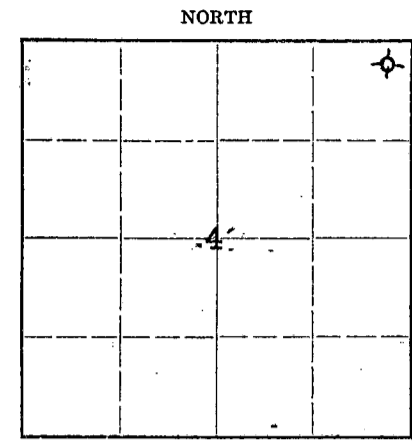

Locate well correctly on above
Section Plat

Name of Conservation Agent who supervised plugging of this well Mr. Ruel Durkee, McPherson, Kansas.

Producing formation. Depth to top. Bottom. Total Depth of Well. 3,537 Feet

Show depth and thickness of all water, oil and gas formations.

OIL, GAS OR WATER RECORDS

CASING RECORD

Formation	Content	From	To	Size	Put In	Pulled Out
				8-5/8	278'	none

Describe in detail the manner in which the well was plugged, indicating where the mud fluid was placed and the method or methods used in introducing it into the hold. If cement or other plugs were used, state the character of same and depth placed, from feet to feet for each plug set.

Jetted pits and circulated heavy mud for thirty minutes - Laid down 1,800' of drill pipe - Filled hole with heavy mud - Laid down balance drill pipe - Filled hole with heavy mud to 200' - placed wood plug at 200' and run 15 sacks cement on this plug - Filled hole with heavy mud to 20' and placed second plug - Run 5 sacks cement to bottom of cellar.

(If additional description is necessary, use BACK of this sheet)

Correspondence regarding this well should be addressed to Donald T. Ingling, 708 4th Nat'l Bank Bldg.,
Address. Wichita 2, Kansas.

STATE OF KANSAS, COUNTY OF SEDGWICK, ss.
I - W.W. Wright (employee of owner) or (owner or operator) of the above-described well,

being first duly sworn on oath, says: That I have knowledge of the facts, statements, and matters herein contained and the log of the above-described well as filed and that the same are true and correct. So help me God.

(Signature) [Handwritten Signature]
708 4th Nat'l Bank Bldg., Wichita, Kansas.
(Address)

SUBSCRIBED AND SWORN to before me this 28th day of November, 1947.
[Handwritten Signature] Notary Public.



PLUGGING
FILE SEC 4 T 16 R 3W
BOOK PAGE 1 LINE 24

15-169-00720-00-00

STATE OF KANSAS
STATE CORPORATION COMMISSION

WELL PLUGGING RECORD

Give All Information Completely
Make Required Affidavit
Mail or Deliver Report to:
Conservation Division
State Corporation Commission
800 Bitting Building
Wichita, Kansas

OR

FORMATION PLUGGING RECORD

Strike out upper line
when reporting plug-
ging of formations.

Saline County. Sec. 4 Twp. 16 Rge. 3 (E) 3 (W)

Location as "NE¹/₄ NW¹/₄ SW¹/₄" or footage from lines NE¹/₄ NE¹/₄ NE¹/₄
Lease Owner W.J. Sherman et al
Lease Name Lindstrom
Office Address Wichita, Kansas.

Well No. 1

Character of Well (completed as Oil, Gas or Dry Hole) Dry Hole
Date well completed Nov. 27, 1947
Application for plugging filed " 27, 1947
Application for plugging approved " 27, 1947
Plugging commenced " 27, 1947
Plugging completed " 27, 1947
Reason for abandonment of well or producing formation.

If a producing well is abandoned, date of last production 19____
Was permission obtained from the Conservation Division or its agents before plugging was com-
menced? Yes

Mr. Ruel Durkee, McPherson, Kansas.

Name of Conservation Agent who supervised plugging of this well
Producing formation Depth to top Bottom Total Depth of Well 3,537 Feet

Show depth and thickness of all water, oil and gas formations.

OIL, GAS OR WATER RECORDS CASING RECORD

Formation	Content	From	To	Size	Put In	Pulled Out
				8-5/8	278'	none

Describe in detail the manner in which the well was plugged, indicating where the mud fluid was placed and the method or methods used in introducing it into the hold. If cement or other plugs were used, state the character of same and depth placed, from _____ feet to _____ feet for each plug.

Jetted pits and circulated heavy mud for thirty minutes - Laid down 1,800' of drill pipe - Filled hole with heavy mud - Laid down balance drill pipe - Filled hole with heavy mud to 200' - placed wood plug at 200' and run 15 sacks cement on this plug - Filled hole with heavy mud to 20' and placed second plug - Run 5 sacks cement to bottom of cellar.

NOV 28 9:17


(If additional description is necessary, use BACK of this sheet.)
Correspondence regarding this well should be addressed to Donald T. Ingling, 708 4th Nat'l Bank Bldg., Wichita 2, Kansas.
Address

KANSAS STATE OF SEDGWICK COUNTY OF _____, SS.

(employee of owner) or (owner or operator) of the above-described well, being first duly sworn on oath, says: That I have knowledge of the facts, statements, and matters herein contained and the log of the above-described well as filed and that the same are true and correct. So help me God.

(Signature) [Signature] 708 4th Nat'l Bank Bldg., Wichita, Kansas.

SUBSCRIBED AND SWORN to before me this 28th day of November, 1947.
Leah O. Landrus
Notary Public.

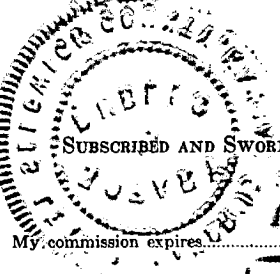

PLUGGING
FILE SEC 4 T 16 R 3W
PAGE 1 LINE 24

15-169-00720-00-00

WELL LOG LINDSTROM NO. 1

W. J. Sherman, et al. - Lease Owners

Sec. 4, Twp. 16S, Range 3W

Donald T. Ingling - Contractor

Location: NE NE NE

Total Depth: 3537'

County: Saline (Kansas)

Commenced: November 2, 1947

Elevation: 1300'

Completed: November 27, 1947

Casing: 278' of 8-5/8"

Production: Dry

figures below indicate bottom of formation:

50	Shale & Sand	2730	Shale
240	Shale & Shells	2780	Shale & Shells
278	Gypsum and Hard Lime	3007	Shale & Cherty Lime
365	Lime	3175	Shale & Lime
550	Lime - Streaks Shale	3220	Shale
740	Lime & Shale	3265	Lime & Shale
890	Sandy Lime	3293	Shale
950	Shale & Lime	3305	Lime & Shale
1010	Sandy Lime & Shale	3365	Cherty Lime
1325	Shale & Shells	3455	Lime
2215	Lime & Shale	3485	Lime & Shale
2365	Lime	3507	Sand & Shale
2425	Lime & Shale	3537	Lime
2470	Lime	3537	<u>TOTAL DEPTH</u>
2560	Lime & Shale		
2600	Shale, Streaks Lime		
2650	Shale & Shells		
2695	Lime & Shale		

I hereby certify that this is a true and correct log of the abovementioned well.

DONALD T. INGLING



STATE OF KANSAS |
 ; SS.
SEDGWICK COUNTY |

Subscribed and sworn to before me, a Notary Public in said County and State this 28th day of November, 1947.



Notary Public

My Commission expires: 4/10/48

PLUGGING
FILE SEC 4 T 16 R 3W
BOOK PAGE 1 LINE 24

15-169-00720-00-00

WELL LOG LINDSTROM NO. 1

W. J. Sherman, et al. - Lease Owners

Sec. 4, Twp. 16S, Range 3W

Donald T. Ingling - Contractor

Location: NE NE NE

Total Depth: 3537'

County: Saline (Kansas)

Commenced: November 2, 1947

Elevation: 1300'

Completed: November 27, 1947

Casing: 278' of 8-5/8"

Production: Dry

Figures below indicate bottom of formation:

50	Shale & Sand	2730	Shale
240	Shale & Shells	2780	Shale & Shells
278	Gypsum and Hard Lime	3007	Shale & Cherty Lime
365	Lime	3175	Shale & Lime
550	Lime - Streaks Shale	3220	Shale
740	Lime & Shale	3265	Lime & Shale
890	Sandy Lime	3293	Shale
950	Shale & Lime	3305	Lime & Shale
1010	Sandy Lime & Shale	3365	Cherty Lime
1325	Shale & Shells	3455	Lime
2215	Lime & Shale	3485	Lime & Shale
2365	Lime	3507	Sand & Shale
2425	Lime & Shale	3537	Lime
2470	Lime	3537	<u>TOTAL DEPTH</u>
2560	Lime & Shale		
2600	Shale, Streaks Lime		
2650	Shale & Shells		
2695	Lime & Shale		

I hereby certify that this is a true and correct log of the abovementioned well.

DONALD T. INGLING

[Handwritten Signature]

STATE OF KANSAS;
; SS.
SEDGWICK COUNTY;

Subscribed and sworn to before me, a Notary Public in said County and State this 28th day of November, 1947.

PLUGGING
FILE SEC 4 T 16 R 3W
BOOK PAGE 1 LINE 24

[Handwritten Signature]
Notary Public

My Commission expires: 4/10/48