

15-169-19174-00-00

STATE OF KANSAS  
STATE CORPORATION COMMISSION  
Give All Information Completely  
Make Required Affidavit  
Mail or Deliver Report to:  
Conservation Division  
State Corporation Commission  
800 Bittling Building  
Wichita, Kansas

WELL PLUGGING RECORD

Saline

County. Sec. 4 Twp. 16S Rge. (E) 3 (W)

Location as "NE/CNW'SW" or footage from lines SE/4 SE/4 NE/4

Lease Owner DeWeese-Sanderson

Lease Name Leander Well No. 1

Office Address Salina, Kansas

Character of Well (completed as Oil, Gas or Dry Hole) Dry Hole

Date well completed November 1, 19 54

Application for plugging filed November 1, 19 54

Application for plugging approved November 1, 19 54


Plugging commenced November 1, 19 54

Plugging completed November 1, 19 54

Reason for abandonment of well or producing formation Dry Hole

If a producing well is abandoned, date of last production None 19

Was permission obtained from the Conservation Division or its agents before plugging was commenced? Yes

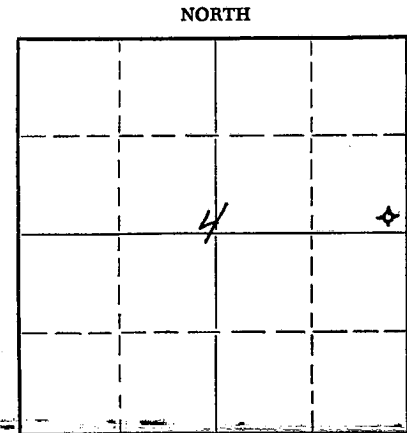

Locate well correctly on above Section Plat

Name of Conservation Agent who supervised plugging of this well Ruel Durkee

Producing formation - Depth to top - Bottom - Total Depth of Well 3375 Feet

Show depth and thickness of all water, oil and gas formations.

OIL, GAS OR WATER RECORDS

CASING RECORD

FORMATION	CONTENT	FROM	TO	SIZE	PUT IN	PULLED OUT
				13-3/8"	105'	None
				8-5/8"	283'	None

Describe in detail the manner in which the well was plugged, indicating where the mud fluid was placed and the method or methods used in introducing it into the hole. If cement or other plugs were used, state the character of same and depth placed, from feet to feet for each plug set.

Heavy mud from 3375' to 275'

Wood plug set at 275'

15 sacks of cement from 275' to 230'

Heavy mud from 230' to 35'

Wood plug set at 35'

10 sacks of cement from 35' to 6'

Surface soil from 6' to 0'

CONSERVATION DIVISION  
WICHITA, KANSAS

Name of Plugging Contractor J. W. Millard  
Address 1111 North Main Hutchinson Kansas

STATE OF Kansas COUNTY OF Saline ss.  
J. W. Sanderson (employee of owner) or (owner or operator) of the above-described


well, being first duly sworn on oath, says: That I have knowledge of the facts, statements, and matters herein contained and the log of the above-described well as filed and that the same are true and correct. So help me God.

(Signature) J. W. Sanderson X

Box 811, Salina, Kans (Address)

SUBSCRIBED AND SWORN TO before me this 12th day of November, 1954

Anna L. Short Notary Public.

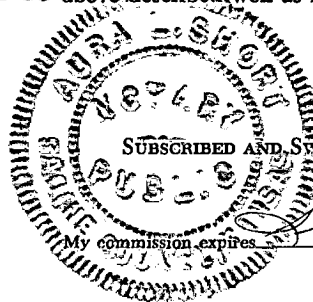

24-7368-S 3-53-20M

PLUGGING  
FILE SEC 4 T 16 R 3W  
BOOK PAGE 25 LINE 5

STATE CORPORATION COMMISSION

NOV 12 1954

CONSERVATION DIVISION  
Wichita, Kansas

15-169-19174-00-00

**WELL RECORD**

LEASE NAME Loander WELL NO. 1 ELEVATION \_\_\_\_\_  
 LOCATION SE/4 SE/4 NE/4 Section 4-16S-3W, Saline County, Kansas  
 WORK COMMENCED October 17, 1954 DRILLING COMMENCED October 18, 1954  
 DRILLING COMPLETED November 1, 1954  
 DRILLING CONTRACTOR J. A. Holland, 1111 North Main St., Hutchinson, Kansas  
 ROTARY DRILLING FROM 0' TO 3375'

FORMATION	FROM	TO	REMARKS
Shale	0	40	
Sand & shale	40	70	
Shale & shells	70	253	Lost circulation @ 250'. Reamed hole to 17" to 105'. Set & cemented 13-3/8" casing at 105' w/ 100 sacks of cement and 1% calcium chloride. 28 hrs.
Lime	253	283	Set and cemented 8-5/8" OD casing w/ 170 sacks of cement from top and 60 sacks of cement from bottom. Casing set @ 253'. Cement circulated. 2 1/2 hrs.
Lime & shale	283	297	Re-cemented casing w/ 50 sacks of cement, 1 sack of calcium chloride & 1 sack of hulls. 39 hrs.
Lime	297	365	
Shale & shells	365	495	
Red bed, shale & shells	495	540	
Lime & shale	540	1000	
Shale	1000	1040	
Shale & shells	1040	1390	
Shale & lime	1390	1420	
Shale	1420	1545	
Shale & lime	1545	1675	
Lime & shale	1675	2075	
Shale & lime	2075	2435	
Lime & shale	2435	2600	
Shale & lime	2600	2650	
Lime & shale	2650	2755	
Shale & lime	2755	2825	
Cherty lime & shale	2825	2845	
Lime & shale	2845	2910	
Cherty lime & shale	2910	3003	
Lime & shale	3003	3025	
Shale & lime	3025	3135	
Shale	3135	3213	
Shale & lime	3213	3338	Circ. for samples @ 3293' 53 min.
Lime	3338	3375	Circ. for samples @ 3355' 1 hr. 15 min.
TOTAL DEPTH		3375	As no oil or gas was encountered in commercial quantities, regular authority was granted to plug and abandon the well under direction of Ruel Durkee, S.C.C. Well Plugger, as follows: Heavy mud from 3375' to 275'. Wood plug set at 275'. 15 sacks of cement from 275' to 230'. Heavy mud from 230' to 35'. Wood plug set at 35'. 10 sacks of cement from 35' to 6'. Surface soil from 6' to 0'. Plugged and abandoned November 1, 1954. Slope tests taken at regular intervals indicated no deflections from vertical.

**PLUGGING**  
 FILE SEC 4 T 16 R 3W  
 BOOK PAGE 75 LINE 5