


Give All Information Completely
Make Required Affidavit
Mail or Deliver Report to:
Conservation Division
State Corporation Commission
800 Bittling Building
Wichita, Kansas

OR

Strike out upper line
when reporting plug-
ging of formations.

FORMATION PLUGGING RECORD

NORTH

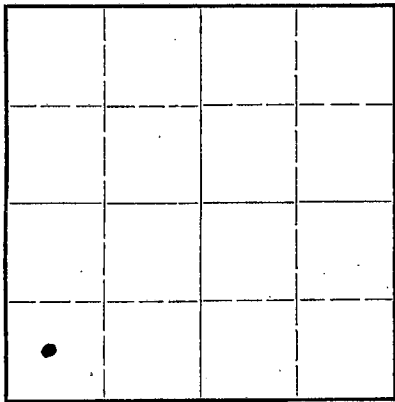

Locate well correctly on above
Section Flat

Saline County. Sec. 3 Twp 16 Rge. 3 (E) (W)
Location as "NE 1/4 NW 1/4 SW 1/4" or footage from lines C SW SW
Lease Owner Westgate-Greenland Oil Company
Lease Name M. Anderson Well No. 1
Office Address 1022 Union Natl Bk Bldg, Wichita 2, Kansas
Character of Well (completed as Oil, Gas or Dry Hole) oil
Date well completed July 8, 1945 19
Application for plugging filed February 25, 1946 19
Application for plugging approved February 27, 1946 19
Plugging commenced February 27, 1946 19
Plugging completed March 1, 1946 19
Reason for abandonment of well or producing formation Production capacity too small
If a producing well is abandoned, date of last production February 25, 1946 19
Was permission obtained from the Conservation Division or its agents before plugging was commenced? yes

Name of Conservation Agent who supervised plugging of this well Ruell Durkee
Producing formation Viola lime Depth to top 3302 Bottom 3312 Total Depth of Well 3355 Feet
Show depth and thickness of all water, oil and gas formations.

OIL, GAS OR WATER RECORDS

CASING RECORD

Formation	Content	From	To	Size	Put In	Pulled Out
Viola	oil	3302	3312	7" O.D.	3385	2595 feet

Describe in detail the manner in which the well was plugged, indicating where the mud fluid was placed and the method or methods used in introducing it into the hold. If cement or other plugs were used, state the character of same and depth placed, from... feet to... feet for each plug set.

Filled with mud and dumped rock 3355' to 3300'
Used bailer and dumped 6 sacks cement 3300' to 3270'
Filled with mud 3270' to 200'
Used bailer and dumped 20 sacks cement 200' to 170'
Filled with mud 170' to 10'
Capped with 5 sacks cement 10' to cellar

3 16 3W
44 35

(If additional description is necessary, use BACK of this sheet)

Correspondence regarding this well should be addressed to G. E. Bitler, c/o Westgate-Greenland Oil Company, Address 1022 Union National Bank Building, Wichita 2, Kansas

STATE OF Kansas, COUNTY OF Sedgwick
G. E. Bitler, Production Superintendent of (employee of owner) or (owner or operator) of the above-described well, being first duly sworn on oath, says: That I have knowledge of the facts, statements, and matters herein contained and the log of the above-described well as filed and that the same are true and correct. So help me God.

(Signature)


G. E. Bitler

1022 Union National Bank Building, Wichita Kansas

March

1946

Notary Public.

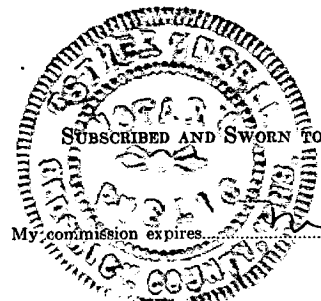


63-08-46

15-169-00919-00-00

COMPANY: WESTGATE-GREENLAND OIL COMPANY
 CONTRACTOR: C C NELSON DRILLING COMPANY
 FARM : M. ANDERSON #1
 LOCATION: C SW/4 of SW/4 of Section 3-16-3W
 Saline County, Kansas
 Commenced: June 18, 1945
 Completed: July 2, 1945

0	to	176	Surface
291	to	375	Sand and shells
375	to	400	Red Bed
400	to	535	Sandy lime
535	to	700	Sand, shale and lime
700	to	840	Sand
840	to	1030	Sand and lime
1030	to	1400	Shale
1400	to	1715	Sand and shale
1715	to	1910	Lime
1910	to	2090	Sandy lime & shale
2090	to	2135	Shale and lime
2135	to	2235	Shale
2235	to	2355	Lime and shale
2355	to	2395	Lime
2395	to	2590	Lime and shale
2590	to	2805	Shale
2805	to	2865	Lime and Chert
2864	to	2875	Chat
2875	to	2965	Cherty lime
2965	to	3015	Chat
3015	to	3030	Chert and lime
3030	to	3090	Lime
3090	to	3215	Shale and lime
3215	to	3302	Shale
3302	to	3308	Viola lime
3308	to	3385	Lime
		3385	T.D.

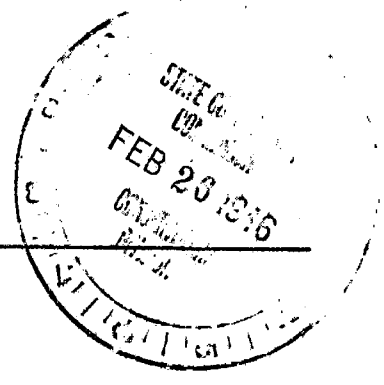


Set 10" SURFACE casing @ 295'
 Set 7" O.D. 20# casing @ 3385 feet.
 Plug back to 3355 feet
 Top Viola Lime @ 3302 feet
 Pay Viola Lime 3302 to 3312 feet
 Perforated 44 holes 3302-3312 feet
 Shot with 7 1/2 Qts. Nitro 3302-3312 feet
 Rotary Table measurements

3 16 3W
 44 35

15-169-00919-00-00

COMPANY: WESTGATE-GREENLAND OIL COMPANY
 CONTRACTOR: C C NELSON DRILLING COMPANY
 FARM : M. ANDERSON #1
 LOCATION: C SW/4 of SW/4 of Section 3-16-3W
 Saline County, Kansas
 Commenced: June 18, 1945
 Completed: July 2, 1945

0	to	176	Surface
291	to	375	Sand and shells
375	to	400	Red Bed
400	to	535	Sandy lime
535	to	700	Sand, shale and lime
700	to	840	Sand
840	to	1030	Sand and lime
1030	to	1400	Shale
1400	to	1715	Sand and shale
1715	to	1910	Lime
1910	to	2090	Sandy lime & shale
2090	to	2135	Shale and lime
2135	to	2235	Shale
2235	to	2355	Lime and shale
2355	to	2395	Lime
2395	to	2590	Lime and shale
2590	to	2805	Shale
2805	to	2865	Lime and Chert
2864	to	2875	Chat
2875	to	2965	Cherty lime
2965	to	3015	Chat
3015	to	3030	Chert and lime
3030	to	3090	Lime
3090	to	3215	Shale and lime
3215	to	3302	Shale
3302	to	3308	Viola lime
3308	to	3385	Lime
		3385	T.D.

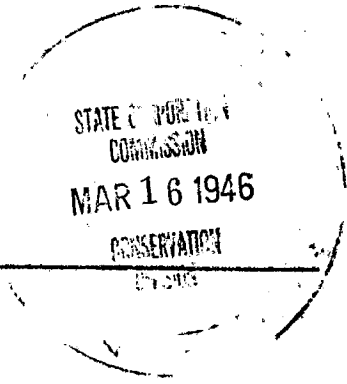

Set 10" SURFACE casing @ 295'
 Set 7" O.D. 20# casing @ 3385 feet.
 Plug back to 3355 feet
 Top Viola Lime @ 3302 feet
 Pay Viola Lime 3302 to 3312 feet
 Perforated 44 holes 3302-3312 feet
 Shot with 7 1/2 Qts. Nitro 3302-3312 feet
 Rotary Table measurements

3 16 3W
 44 35