


STATE OF KANSAS STATE CORPORATION COMMISSION

WELL PLUGGING RECORD

Give All Information Completely Make Required Affidavit Mail or Deliver Report to: Conservation Division, State Corporation Commission 212 No. Market Wichita, Kansas

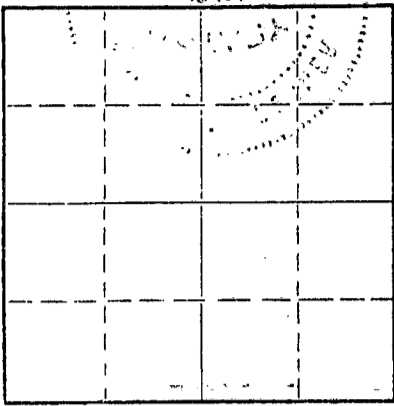

Locate well correctly on above Section Plat

Saline County, Sec. 3 Twp. 16 Rge. 3 (E) (W) Location as "NE/CNW/SW" or footage from lines C SW NW Lease Owner Sterling, Drilling Company Lease Name Bengtson, Bengtson #1 Well No. Office Address Sterling, Kansas 67579 Character of Well (completed as Oil, Gas or Dry Hole) Date well completed Application for plugging filed Application for plugging approved Plugging commenced 8/1/69 Plugging completed 8/7/69 Reason for abandonment of well or producing formation depleted.

If a producing well is abandoned, date of last production Was permission obtained from the Conservation Division or its agents before plugging was commenced? yes

Name of Conservation Agent who supervised plugging of this well Toman Producing formation Depth to top Bottom Total Depth of Well 3360 Feet Show depth and thickness of all water, oil and gas formations.

OIL, GAS OR WATER RECORDS

CASING RECORD

Table with 7 columns: FORMATION, CONTENT, FROM, TO, SIZE, PUT IN, PULLED OUT. Includes a 'RECEIVED' stamp from the State Corporation Commission dated AUG 12 1969.

Describe in detail the manner in which the well was plugged, indicating where the mud fluid was placed and the method or methods used in introducing it into the hole. If cement or other plugs were used, state the character of same and depth placed, from feet to feet for each plug set.

Checked bottom, cleaned cellar, ran sand to 3280' and dumped 5 sacks of cement. Shot pipe at 2743', 2648', 2339', 2142', 1824', 1529', 1306', 1116', 1021', worked pipe loose and pulled 32 joints. Set 10' rock bridge @ 309' and dumped 25 sacks of cement. Mudded to 40' and dumped 10 sacks of cement. Tallied pipe.

PLUGGING COMPLETE.

Name of Plugging Contractor KNIGHT CASING PULLING CO., INC. Address CHASE, KANSAS

STATE OF Kansas COUNTY OF Rice, ss. Noel J. Knight (employee of owner) or (owner or operator) of the above-described well, being first duly sworn on oath, says: That I have knowledge of the facts, statements, and matters herein contained and the log of the above-described well as filed and that the same are true and correct. So help me God.

(Signature) Noel Knight Chase, Kansas (Address)

Subscribed and sworn to before me this 8th day of August, 1969. Margaret Melcher Notary Public.

