


STATE OF KANSAS  
STATE CORPORATION COMMISSION

Give All Information Completely  
Make Required Affidavit  
Mail or Deliver Report to:  
Conservation Division  
State Corporation Commission  
800 Bittling Building  
Wichita, Kansas

15-169-00560-00-00  
WELL PLUGGING RECORD

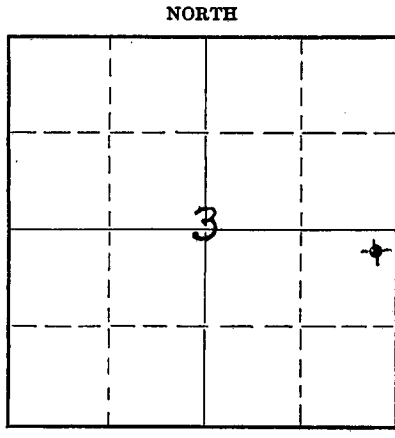

Saline County. Sec. 3 Twp. 16 Rge. 3 (E) W. (W)  
Location as "NE/CNW $\frac{1}{4}$ SW $\frac{1}{4}$ " or footage from lines NE NE SE  
Lease Owner H. S. Currier  
Lease Name Martin Well No. 2  
Office Address 155 S. Santa Fe Ave., Box 164 Salina, Kansas.  
Character of Well (completed as Oil, Gas or Dry Hole) Oil well  
Date well completed March 30, 1950  
Application for plugging filed November 20, 1951  
Application for plugging approved November 30, 1951  
Plugging commenced December 12, 1951  
Plugging completed December 28, 1951  
Reason for abandonment of well or producing formation  
Ceased to produce oil & turned to water  
If a producing well is abandoned, date of last production May 1, 1951  
Was permission obtained from the Conservation Division or its agents before plugging was commenced? yes

Locate well correctly on above Section Plat

Name of Conservation Agent who supervised plugging of this well Mr Ruel Durkee  
Producing formation Crystalline Viola Depth to top 3403 Bottom 3410 Total Depth of Well 3415 Feet  
Show depth and thickness of all water, oil and gas formations.

OIL, GAS OR WATER RECORDS

CASING RECORD

Formation	Content	From	To	Size	Put In	Pulled Out
Sandy lime	salty water	275	280	8-5/8"	325'	none
Top crystalline Viola	oil	surface	3403'	5-1/2"	3403'	2935'

Describe in detail the manner in which the well was plugged, indicating where the mud fluid was placed and the method or methods used in introducing it into the hole. If cement or other plugs were used, state the character of same and depth placed, from \_\_\_\_\_ feet to \_\_\_\_\_ feet for each plug set.

Dumped (6) sacks of cement at 3415'  
Filled with rocks back up to 3330'  
Dumped (4) sacks of cement at 3330'  
Mudded the hole from top of cement plug at 3330' back up to 160'  
Set rock bridge and put (15) sacks of cement at 160'  
Finished mudding hole and put (5) sacks of cement at top of surface casing.

RECEIVED  
STATE CORPORATION COMMISSION  
JAN 12 1952  
CONCERNING THE ABOVE WELL

(If additional description is necessary, use BACK of this sheet)


Correspondence regarding this well should be addressed to H. S. Currier  
Address 155 S. Santa Fe Ave., Box 164 Salina, Kansas.

STATE OF Kansas, COUNTY OF Saline, ss.  
H. S. Currier (employee of owner) or (owner or operator) of the above-described well,  
being first duly sworn on oath, says: That I have knowledge of the facts, statements, and matters herein contained and the log of the above-described well as filed and that the same are true and correct. So help me God.

(Signature) *H. S. Currier*  
(as above)  
(Address)

SUBSCRIBED AND SWORN to before me this 5th day of January 1952

*Clarence B. Stewart*  
Notary Public.

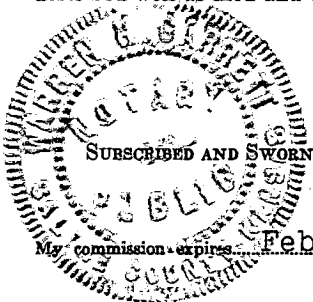

PLUGGING  
FILE SEC 3 T 16 R 3 W  
BOOK PAGE 134 LINE 1

Copy

15-169-00560-00-00

ROTARY DRILLER'S LOG

Currier & Keys, etal  
155 South Satna Fe  
Salina, Kansas

Elevation: 1319 D.F. 1321.30 K.B.  
D.F. 3120' & K.B. 5.50'  
above 8-5/8" x 5 1/2"  
Suspension Head.  
Top Viola Lime-3389 K.B.  
Total Depth -3408 K.B.  
Bottom of 5 1/2" Shoe 3403 K.B.

Martin #1

0 NE/4 NE/4 SE/4  
Sec. 3-16S-8W  
Salina County, Kansas

Casing Record: 8-5/8" 28' 325' K.B.  
Lost circulation 278,  
staged w/225 sax cement  
& 10 sax cal seal until  
it filled back to cellar.  
5 1/2" 15.5' J-55 cemented at  
3403 w/75 sacks

Commenced: 3-15-50  
Completed: 3-31-50

Contractor: E. K. Carey, Contractor (Rig #2) Box 620, McPherson, Kansas.

Figures Indicate Bottom of Formation K. B.

Rotary table, base & cellar	8	Shale	2250
Shale	130	Lime	2360
Shale & shells	275	Lime & shale	2625
Sandy Lime	280	Shale	2655
Lime	300	Lime & shale	2715
Shale & lime	320	Shale & lime	2830
Lime	325	Shale	2840
Lime & shale	485	Ass. Lime	3030
Shale & lime	760	Shale & lime	3042
Lime & shale	940	Lime	3090
Shale & shells	1285	Shale	3114
Shale & lime	1700	Shale & lime	3315
Lime	1815	Shale	3336
Lime & shale	1900	Lime & chert	3389
Lime	1990	Viola lime	3403 TD

Geologist on this well: Donald Hoy Smith, Wichita, Kansas

The above Rotary Driller's Log is complete and correct to the best of my knowledge.

E. K. CAREY, CONTRACTOR

By Herbert Rhoton, Supt.

PLUGGED  
SEC 3-16S-8W  
WELL NO. 15-169-00560-00-00