


15-101-19003-00-00

WELL PLUGGING RECORD

Give All Information Completely
Make Required Affidavit
Mail or Deliver Report to:
Conservation Division
State Corporation Commission
211 No. Broadway
Wichita, Kansas

Lane _____ County. Sec. 19 Twp. 16S Rge. 27W (E) _____ (W) _____
Location as "NE/CNW%SW%" or footage from lines Approx. C. W/2 SE/4
Lease Owner G-R-O c/o W. F. Roland
Lease Name Gates Well No. 2
Office Address 52 Drake, Pueblo, Colorado
Character of Well (completed as Oil, Gas or Dry Hole) Dry Hole
Date well completed April 12 19 64
Application for plugging filed April 12 19 64
Application for plugging approved April 12 19 64
Plugging commenced April 12 19 64
Plugging completed April 12 19 64
Reason for abandonment of well or producing formation Dry Hole

NORTH

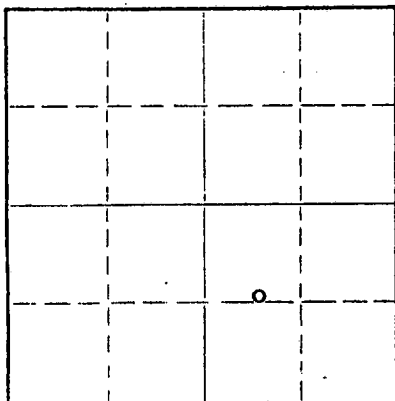

Locate well correctly on above
Section Plat

If a producing well is abandoned, date of last production _____ 19 _____
Was permission obtained from the Conservation Division or its agents before plugging was commenced? yes

Name of Conservation Agent who supervised plugging of this well W. L. Nichols, Moreland, Kansas
Producing formation _____ Depth to top _____ Bottom _____ Total Depth of Well _____ Feet
Show depth and thickness of all water, oil and gas formations.

OIL, GAS OR WATER RECORDS

CASING RECORD

FORMATION	CONTENT	FROM	TO	SIZE	PUT IN	PULLED OUT
		0	254'	8 5/8"	254'	none

Describe in detail the manner in which the well was plugged, indicating where the mud fluid was placed and the method or methods used in introducing it into the hole. If cement or other plugs were used, state the character of same and depth placed, from _____ feet to _____ feet for each plug set.

Set Plug @ 600'/20 sacks cement
24'/20 sacks cement
40'/10 sacks cement

RECEIVED
STATE CORPORATION COMMISSION

MAY 8 1964

05-08-1964
CONSERVATION DIVISION
Wichita, Kansas

(If additional description is necessary, use BACK of this sheet)

Name of Plugging Contractor Hellar Drilling Company, Inc.
Address 1014 Union Center, Wichita, Kansas

STATE OF Kansas COUNTY OF Sedgwick, ss.
D. L. Hellar, Pres. of Hellar Drilling Co. Inc. (employee of owner) or (owner or operator) of the above-described


well, being first duly sworn on oath, says: That I have knowledge of the facts, statements, and matters herein contained and the log of the above-described well as filed and that the same are true and correct. So help me God.

(Signature) D. L. Hellar D. L. Hellar, President
1014 Union Center, Wichita, Kansas 67202
(Address)

SUBSCRIBED AND SWORN TO before me this 7th day of May, 19 64

March 25, 1968.
Catherine Darcey Notary Public.

My commission expires _____

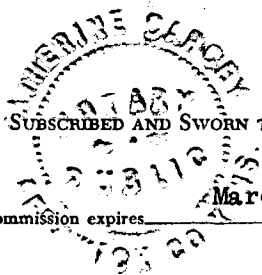

15-101-19003-00-00

DRILLER'S LOG

COMPANY: G-R-O c/o W. F. Roland
 CONTRACTOR: Hellar Drilling Company, Inc.
 LEASE: #2 Gates
 LOCATION: Approx. c W/2 SE/4 Sec. 19-16S-27W
 Lane County, Kansas
 COMMENCED: March 31, 1964
 COMPLETED: April 12, 1964
 CASING: Set 8 5/8" surface casing @ 254'/200 sacks cement

0-254	Shells, Clay
254-1342	Shale & shells
1342-1595	Sand & shale
1595-1630	Anhydrite
1630-2010	Shale
2010-2170	Shale & shells
2170-2208	Anhydrite
2208-2530	Shale & shells
2530-2675	Shale & lime
2675-2770	Lime & shale
2770-2900	Ft. Riley Section
2900-3090	Shale & lime
3090-3225	Lime & shale
3225-3425	Lime
3425-3455	Lime & shale
3455-3747	Lime, Chalky lime & shale
3747-3805	Chalky lime
3805-4268	Lime
4268-4400	Lime & shale
4400-4440	Lime
4440-4474	Lime & shale (cherty)
4474-4613	Lime
4613	Rotary Total Depth

FILED IN THE
STATE CONTROLLER'S OFFICE

MAY 7 1964
05-08-1964
CONSERVATION DIVISION
Wichita, Kansas

D & A

STATE OF KANSAS)
) ss
 COUNTY OF SEDGWICK)

I, D. L. Hellar, do hereby certify that the above and foregoing is a true and correct copy of the log of the #2 Gates, located in approx. c W/2 SE/4 Sec. 19-16S-27W, Lane County, Kansas, as reflected by the files of the Hellar Drilling Company, Inc.

HELLAR DRILLING COMPANY, INC.

By *D. L. Hellar*
 President - D. L. Hellar

Subscribed and sworn to before me, a Notary Public, in and for Sedgwick County, Kansas, this 7th day of May, 1964.

My Commission Expires:
 March 25, 1968.

Catherine Darcey
 Notary Public - Catherine Darcey