


WELL PLUGGING RECORD

Give All Information Completely
Make Required Affidavit
Mail or Deliver Report to:
Conservation Division
State Corporation Commission
211 No. Broadway
Wichita, Kansas

Lane _____ County. Sec. 19 Twp. 16S Rge. 27W (E) _____ (W) _____
Location as "NE/CNW/SW" or footage from lines. C NW SE
Lease Owner G-R-O c/o W. F. Roland
Lease Name Gates Well No. 2-X
Office Address 52 Drake, Pueblo, Colorado
Character of Well (completed as Oil, Gas or Dry Hole) _____
Date well completed April 23 19 64
Application for plugging filed April 23 19 64
Application for plugging approved April 23 19 64
Plugging commenced April 23 19 64
Plugging completed April 23 19 64
Reason for abandonment of well or producing formation Dry Hole

NORTH

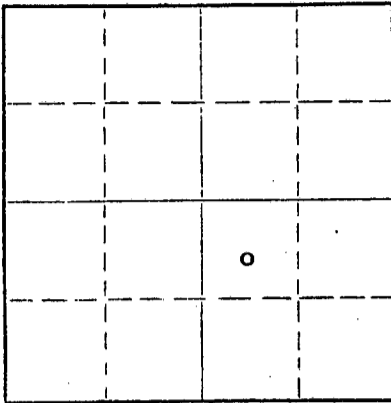

Locate well correctly on above Section Plat

If a producing well is abandoned, date of last production _____ 19 _____
Was permission obtained from the Conservation Division or its agents before plugging was commenced? Yes

Name of Conservation Agent who supervised plugging of this well W. L. Nichols, Moreland, Kansas
Producing formation _____ Depth to top _____ Bottom _____ Total Depth of Well _____ Feet
Show depth and thickness of all water, oil and gas formations.

OIL, GAS OR WATER RECORDS

CASING RECORD

FORMATION	CONTENT	FROM	TO	SIZE	PUT IN	PULLED OUT
		0	256'	8 5/8"	256'	none

Describe in detail the manner in which the well was plugged, indicating where the mud fluid was placed and the method or methods used in introducing it into the hole. If cement or other plugs were used, state the character of same and depth placed, from _____ feet to _____ feet for each plug set.

Set Plug @ 600'/20 sacks cement, 1/2 sack hulls
250'/15 sacks cement, 1/2 sack hulls
40'/10 sacks cement, 1/2 sack hulls

RECEIVED
STATE CORPORATION COMMISSION

MAY 8 1964
05-08-1964
CONSERVATION DIVISION
Wichita, Kansas

(If additional description is necessary, use BACK of this sheet)
Name of Plugging Contractor Hellar Drilling Company, Inc.
Address 1014 Union Center, Wichita, Kansas 67202

STATE OF Kansas, COUNTY OF Sedgwick, ss.

D. L. Hellar, Pres. of Hellar Drilling Co. Inc. (employee of owner) or (owner or operator) of the above-described well, being first duly sworn on oath, says: That I have knowledge of the facts, statements, and matters herein contained and the log of the above-described well as filed and that the same are true and correct. So help me God.

(Signature) D. L. Hellar D. L. Hellar, President
1014 Union Center, Wichita, Kansas 67202

Subscribed and Sworn to before me this 7th day of May, 1964

Catherine Darcey
Catherine Darcey Notary Public.

My commission expires March 25, 1968

