

STATE OF KANSAS  
STATE CORPORATION COMMISSION  
130 S. Market, Room 2078  
Wichita, KS 67202

WELL PLUGGING RECORD  
K.A.R.-82-3-117

API NUMBER 15-101-21797-0000

LEASE NAME Herl Trust "A"

WELL NUMBER 1-16

330 Ft. from S Section Line

990 Ft. from <sup>W</sup> Section Line

SEC. 16 TWP. 16 RGE. 27 ~~W~~ or (W)

COUNTY Lane

Date Well Completed 3-3-02

Plugging Commenced 3-3-02

Plugging Completed 3-3-02

RECEIVED  
03-06-2002  
MAR 06 2002  
KCC WICHITA

TYPE OR PRINT  
NOTICE: Fill out completely  
and return to Cons. Div.  
office within 30 days.

LEASE OPERATOR Trans Pacific Oil Corporation

ADDRESS 100 S. Main, Ste. 200, Wichita, KS 67202

PHONE (316) 262-2596 OPERATORS LICENSE NO. 9408

Character of Well D & A

(Oil, Gas, D&A, SWD, Input, Water Supply Well)

The plugging proposal was approved on 3-3-02 (date)

by Kevin Strube (KCC District Agent's Name)

Is ACO-1 filed? No If not, is well log attached? Yes

Producing Formation \_\_\_\_\_ Depth to Top \_\_\_\_\_ Bottom T.D. 4,620'

Show depth and thickness of all water, oil and gas formations.

OIL, GAS OR WATER RECORDS

CASING RECORD

Formation	Content	From	To	Size	Put In	Pulled out
				8 5/8"	215'	Cmtd. w/150 sax

Describe in detail the manner in which the well was plugged, indicating where the mud fluid was placed and the method or methods used in introducing it into the hole. If cement or other plugs were used, state the character of same and depth placed, from    feet to    feet each section. Push bridge plug to 2,120', spot 50 sax cement on plug; push bridge plug to 1,300', spot 50 sax cement on plug; push plug to 650', spot 40 sax cement on plug; push bridge plug to 250', spot 50 cement on plug; push wiper plug to 40', dump 10 sax cement on plug to cellar; dump 15 sax cement down rat hole and 10 sax cement down mouse hole.

Name of Plugging Contractor Shields Drilling Co. License No. 5184

Address Box 709, Russell, KS 67665

NAME OF PARTY RESPONSIBLE FOR PLUGGING FEES: Trans Pacific Oil Corporation

STATE OF KANSAS COUNTY OF RUSSELL, ss.


Jack P. Beeman, Sec.-Treas. Contractor  
above-described well, being first duly sworn on oath, says: That I have knowledge of the fact statements, and matters herein contained and the log of the above-described well as filed in the same are true and correct, so help me God.

(Signature) Jack P. Beeman

(Address) Box 709, Russell, KS 67665

SUBSCRIBED AND SWORN TO before me this 4th day of March, 2002

My Commission Expires: \_\_\_\_\_

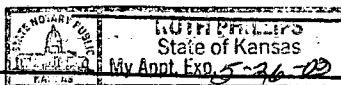

Notary Public



# Shields


15-101-21997-00-00

Russell, Kansas

## WELL LOG

Operator: Trans Pacific Oil Corp.  
 Well: Herl Trust "A" #1-16  
 Commenced: February 18, 2002  
 Completed: March 3, 2002  
 Contractor: Shields Drilling Co.

Well Description: SW SE SE  
 Sec. 16-16S-27W  
 Lane Co., KS

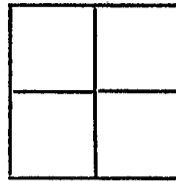

Elevation: 2,668' KB

Treatment:

Production: D & A

Tops:

### CASING RECORD

Size	Run	Pulled
8 5/8"	215'	Cmtd. w/150 sax

RECEIVED

MAR 06 2002  
 03-06-2002  
 KCC WICHITA

..... Figures Indicate Bottom of Formations .....

Rock & shale	60'
Shale	217'
Sand & shale	2,038'
Shale	2,080'
Anhydrite	2,118'
Shale	3,667'
Shale & lime	4,212'
Lime	4,247'
Lime & shale	4,304'
Lime	4,447'
Lime & shale	4,480'
Lime	4,620' RTD

Notes