


Give All Information Completely
Make Required Affidavit
Mail or Deliver Report to:
Conservation Division
State Corporation Commission
212 No. Market
Wichita, Kansas

WELL PLUGGING RECORD

Saline County, Sec. 17 Twp. 16 Rge. 3 (E) (W)
Location as "NE/CNW/SW" or footage from lines C SW SW

Lease Owner Kirby Petro, Co.
Lease Name Swenson B Well No. 2
Office Address 402 1st Nat'l Bank Bldg, Pawhuska, Oklahoma
Character of Well (completed as Oil, Gas or Dry Hole) oil well
Date well completed 12-19-52 19
Application for plugging filed 6-5-67 19
Application for plugging approved 6-5-67 19
Plugging commenced 7-6-67 19
Plugging completed 7-10-67 19
Reason for abandonment of well or producing formation depleted

NORTH

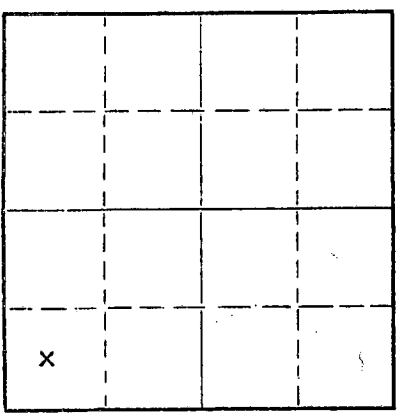

Locate well correctly on above Section Plat

If a producing well is abandoned, date of last production 19
Was permission obtained from the Conservation Division or its agents before plugging was commenced? yes

Name of Conservation Agent who supervised plugging of this well Gilbert Toman
Producing formation Maquoketa Depth to top 3432 Bottom 3436 Total Depth of Well 3436 Feet
Show depth and thickness of all water, oil and gas formations.

OIL, GAS OR WATER RECORDS

CASING RECORD

FORMATION	CONTENT	FROM	TO	SIZE	PUT IN	PULLED OUT
				10 3/4	163'	none
				8 5/8	490'	none
				5 1/2	3432'	2939'

Describe in detail the manner in which the well was plugged, indicating where the mud fluid was placed and the method or methods used in introducing it into the hole. If cement or other plugs were used, state the character of same and depth placed, from feet to feet for each plug set.

Fill hole with chat from 3436' to 3410' and dump 5 sacks of cement
Set 10' rock bridge from 285' to 275' and dump 25 sacks of cement
Mud hole to 35', rock from 35' to 30' and dump 10 sacks of cement to surface

RECEIVED
STATE OF KANSAS
CONSERVATION DIVISION

AUG 11 1967

CONSERVATION DIVISION
Wichita, Kansas


Name of Plugging Contractor Flint Engineering and Const. Co.
Address 2375 W. Central El Dorado, Kansas

STATE OF Kansas COUNTY OF Butler, ss.

(employee of owner) or (owner or operator) of the above-described well, being first duly sworn on oath, says: That I have knowledge of the facts, statements, and matters herein contained and the log of the above-described well as filed and that the same are true and correct. So help me God.

(Signature) *James Davis*

(Address) _____, 19 67

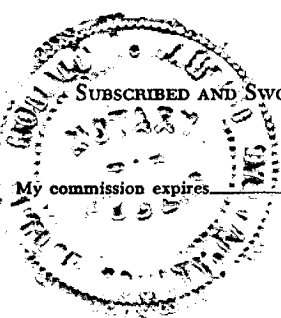

My commission expires Sept. 27, 1967

Ronald R. Hanson
Notary Public.

C.

15-169-00588-000

NATIONAL ASSOCIATED PETROLEUM COMPANY

SWENSON NO. 2-B Location: Cen. SW SW
SALINE COUNTY, KANSAS 17-16S-3W

Drilling Contractor: Exploration Drilling Co.
220 North Boston
Tulsa, Oklahoma

Started Rigging Up : 12- 5-52
Started Drilling : 12- 9-52
Completed Drilling : 12-19-52

Set: 5 Joints of 10 3/4" Surface Casing
@ 163' W/150 Sacks of Cement.

Set: 117 Joints of 5 1/2"
Casing @ 3433' W/75
Sacks of Cement.

10 Joints of 8 5/8" Intermediate Casing
@ 490' @/100 Sacks of Cement.

FORMATIONS

Surface	0'	185'
Shale	185	230
Shale & Shells	230	380
Anhydrite	380	385
Anhydrite & Shale	385	435
Anhydrite	435	517
Shale & Shells	517	610
Shale & Lime	610	1275
Shale & Shells	1275	1600
Shale	1600	1900
Shale & Lime	1900	2050
Shale	2050	2300
Shale & Lime	2300	2370
Shale	2370	2439
Sand	2439	2470
Shale & Lime	2470	2950
Chert & Shale Breaks	2950	2991
Cherty Lime & Shale	2991	3038
Lime & Shale	3038	3090
Lime & Chert	3090	3137
Lime, Chert & Chat	3137	3165
Lime, Shale & Chert	3165	3207
Shale & Lime	3207	3436 Total Depth

RECEIVED
STATE CORPORATION COMMISSION
JUN 6 1967
CONSERVATION DIVISION
Wichita, Kansas

CERTIFICATION

This is to certify that the above and foregoing is a true, correct, and complete copy of the Driller's Log covering the Swenson No. 2-B according to the records of this office and the best of my knowledge and belief.

EXPLORATION DRILLING COMPANY

By Gloria M. Kee
Notary Public

Subscribed and sworn to before me this 20th day of December, 1952.
My commission expires April 25, 1954.