


Give All Information Completely
Make Required Affidavit
Mail or Deliver Report to:
Conservation Division
State Corporation Commission
212 No. Market
Wichita, Kansas

WELL PLUGGING RECORD

NORTH

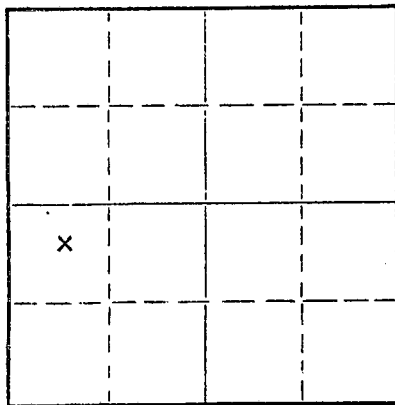

Locate well correctly on above
Section Plat

Saline County, Sec. 17 Twp. 16 Rge. 3 (W)
Location as "NE/CNWxSWx" or footage from lines. C NW SW
Lease Owner Kirby Petro. Co.
Lease Name Swenson D Well No. 2
Office Address 402 1st Nat'l Bank Bldg. Pawhuska, Oklahoma
Character of Well (completed as Oil, Gas or Dry Hole) oil well
Date well completed 1-5-53 19
Application for plugging filed 6-5-67 19
Application for plugging approved 6-6-67 19
Plugging commenced 6-23-67 19
Plugging completed 6-26-67 19
Reason for abandonment of well or producing formation depleted

If a producing well is abandoned, date of last production 19
Was permission obtained from the Conservation Division or its agents before plugging was commenced? yes

Name of Conservation Agent who supervised plugging of this well Gilbert Toman
Producing formation Maquoketa Depth to top 3446 Bottom 3452 Total Depth of Well 3452 Feet
Show depth and thickness of all water, oil and gas formations.

OIL, GAS OR WATER RECORDS

CASING RECORD

FORMATION	CONTENT	FROM	TO	SIZE	PUT IN	PULLED OUT
				10 3/4	158'	none
				5 1/2	3446'	2970'

Describe in detail the manner in which the well was plugged, indicating where the mud fluid was placed and the method or methods used in introducing it into the hole. If cement or other plugs were used, state the character of same and depth placed, from _____ feet to _____ feet for each plug set.

Fill hole with chat from 3452' to 3400' and dump 5 sacks of cement

Set 10' rock bridge from 210' to 200' and dump 25 sacks of cement

Mud hole to 30', set 10' rock bridge from 30' to 20' and dump 10 sacks of cement to surface

RECEIVED
STATE CORPORATION COMMISSION

AUG 4 1967

CONSERVATION DIVISION
Wichita, Kansas

(If additional description is necessary, use BACK of this sheet)

Name of Plugging Contractor Flint Engineering and Const. Co.
Address 2375 W. Central El Dorado, Kansas

STATE OF Kansas, COUNTY OF Butler, ss.

(employee of owner) or (owner or operator) of the above-described well, being first duly sworn on oath, says: That I have knowledge of the facts, statements, and matters herein contained and the log of the above-described well as filed and that the same are true and correct. So help me God.

(Signature) *James Davis*

(Address) _____, 19 67

Ronald R. Hanson

Notary Public.

Subscribed and Sworn to before me this 2 day of August, 1967
My commission expires Sept. 27, 1967



Office Memorandum

From Bill M. Lincicome

Date January 9, 1952

To Forrest H. Lindsay

Lindsay-Vinson's
 Subject #2 Swenson "D" - Cen. NW SW

17-16S-3W, Saline Co., Kansas

Type: North Holm Field

Elev.: 1383'DF; 1384'KB

Status: Oil Well

Total Depth: 3452' Drillers (No Schlumberger run)

Dates: Drilled under surface 12-22-52; Set Long String 1-5-53.

Casing: Surface: Ran 5 joints of 10-3/4" H-40, 153.85', set at 158'; cem. w/ 125 sx; p.d. 5:00 a.m. 12-22-52.

Long String: Ran 113 joints of 5-1/2" J-55 3494.21'; set at 3446; cem. w/75 sx; p.d. 1:30 a.m. 1-5-53.

Special Tests: Johnston Testers; Conventional Coring.

TOPS

Formation	Sample	(No Schlumberger run)
Lansing-Kansas City	2298	
Mississippi	2951	
Kinderhook	3216	
Maquoketa sh.	3428	
Maquoketa dolo.	3445	

RECEIVED
 STATE CORPORATION COMMISSION
 JAN 6 1952
 CONSERVATION DIVISION
 Wichita, Kansas

DESCRIPTION OF SPECIAL TESTS

Core #1 - 3446-49 (Maquoketa dolo.) Cut 3', Rec. 6"; Time 39-44-66; Rec. 6" gy., med., to coarse xln. cherty dolo. w/scattered vugs w/SFO.

Core #2 - 3449-52 (Maquoketa dolo.) Cut 3', Rec. 6"; Time 41-49-56; Rec. 6" gray to tan soft coarse xln. dolo. w/vertical fractures, good SFO.

DST #1 - 3445-59; Open 2 hrs.; weak blow 12 min.; Rec. 25' drlg. mud; BHP 330#/30 min.

Respectfully submitted,

/s/ Bill M. Lincicome

BML:cg