


Give All Information Completely
Make Required Affidavit
Mail or Deliver Report to:
Conservation Division
State Corporation Commission
212 North Market, Insurance Bldg.
Wichita, Kansas

WELL PLUGGING RECORD

Ness County. Sec. 5 Twp. 16S Rge. 25 (E) W (W)

Location as "NE/CNW/SW" or footage from lines SE/4 SE/4
Lease ~~XXXX~~ Operator: Joe Josephson & Miami Petroleum Company, Inc.
Lease Name EVEL Well No. 1
Office Address Joe Josephson, 5646 Loring Drive, Dallas 9, Texas
Miami Petroleum Company, Inc., Box 2040, Abilene, Texas
Character of Well (completed as Oil, Gas or Dry Hole) Dry Hole
Date well completed July 23, 19 61
Application for plugging filed (verbal) July 23, 19 61
Application for plugging approved (verbal) July 24, 19 61
Plugging commenced July 24, 19 61
Plugging completed July 24, 19 61
Reason for abandonment of well or producing formation Dry Hole

NORTH

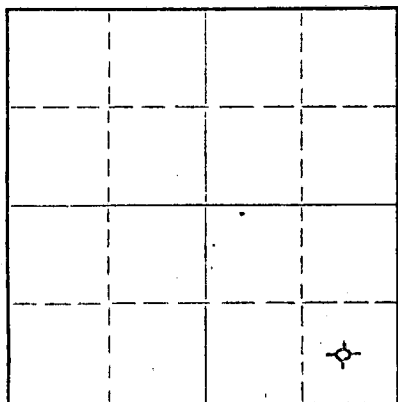

Locate well correctly on above
Section Plat

If a producing well is abandoned, date of last production _____ 19____
Was permission obtained from the Conservation Division or its agents before plugging was commenced? Yes

Name of Conservation Agent who supervised plugging of this well Gilbert Lieker
Producing formation _____ Depth to top _____ Bottom _____ Total Depth of Well 4590 Feet
Show depth and thickness of all water, oil and gas formations.

OIL, GAS OR WATER RECORDS

CASING RECORD

FORMATION	CONTENT	FROM	TO	SIZE	PUT IN	PULLED OUT
		0	236'	8-5/8"	236'	none

Describe in detail the manner in which the well was plugged, indicating where the mud fluid was placed and the method or methods used in introducing it into the hole. If cement or other plugs were used, state the character of same and depth placed, from _____ feet to _____ feet for each plug set.

Bottom plug set at 230' with 20 sacks cement on top.
Top plug set at 40' with 10 sacks cement.

RECEIVED
STATE CORPORATION COMMISSION
AUG 11 1961
CONSERVATION DIVISION
Wichita, Kansas

(If additional description is necessary, use BACK of this sheet)
Name of Plugging Contractor Birmingham-Bartlett Drilling Co.
Address 300 Kaufman Bldg., Wichita 2, Kansas

STATE OF KANSAS, COUNTY OF SEDGWICK
Richard Hindery, Partner of Birmingham-Bartlett Drilling Co., Contractor
(employee of owner) or (owner or operator) of the above-described well, being first duly sworn on oath, says: That I have knowledge of the facts, statements, and matters herein contained and the log of the above-described well as filed and that the same are true and correct. So help me God. BIRMINGHAM-BARTLETT DRILLING CO.

(Signature) BY Richard Hindery Partner
300 Kaufman Bldg., Wichita 2, Kansas
(Address)

SUBSCRIBED AND SWORN to before me this 25th day of July, 19 61.



Beverly Larson
Beverly Larson Notary Public.

EVEL NO. 1 WELL

LOCATION: SE/4 SE/4
Section 5-16S-25W
Ness County, Kansas

SPUDDED: 7-10-61
DRILLING
COMPLETED: 7-23-61

OPERATOR: Joe Josephson
5646 Loring Drive
Dallas 9, Texas

Miami Petroleum Company, Inc.
Drawer 2040
Abilene, Texas

SURFACE CASING: 8-5/8" surface casing cemented
at 236' with 175 sacks cement.

OIL STRING: None set. Dry and abandoned.
Plugging completed 7-24-61.

CONTRACTOR: Birmingham-Bartlett Drilling Co.
300 Kaufman Bldg.
Wichita 2, Kansas

LOG

(Figures indicate bottom of formation)

0 -	50	Surface clay
	105	Clay and shale
	135	Sand
	310	Shale
	835	Shale and shells
	1025	Sand
	1358	Shale and shells
	1374	Blaine anhydrite
	1765	Shale and sand
	1967	Shale and shells
	1999	Anhydrite
	2030	Shale
	2265	Shale and shells
	2505	Shale
	3930	Lime and shale
	3975	Lime
	4060	Shale and lime
	4170	Lime
	4220	Lime and shale
	4342	Lime
	4420	Lime and shale
	4424	Lime
	4494	Lime and shale
	4498	Lime
	4505	Cherty lime
	4512	Dolomite
	4560	Lime
	4575	Cherty lime
	4590	Lime
	4590	Rotary total depth

STATE COMMISSION

AUG 11 1961

CONSERVATION DIVISION
Wichita, Kansas

The undersigned, Richard Hindery, one of the partners of Birmingham-Bartlett Drilling Co., hereby certifies that the above is a true and correct log of the formations encountered in drilling the Evel No. 1 Well as shown in the daily drilling reports.

BIRMINGHAM-BARTLETT DRILLING CO.

By Richard Hindery
Richard Hindery, Partner

Subscribed and sworn to before me
this 25th day of July, 1961

My commission expires Oct. 2, 1962.

Beverly Larson
Beverly Larson, Notary Public