


STATE OF KANSAS
STATE CORPORATION COMMISSION

15-169-19128-00-00 Form CP-4
WELL PLUGGING RECORD

Give All Information Completely
Make Required Affidavit
Mail or Deliver Report to:
Conservation Division
State Corporation Commission
211 No. Broadway
Wichita, Kansas

NORTH

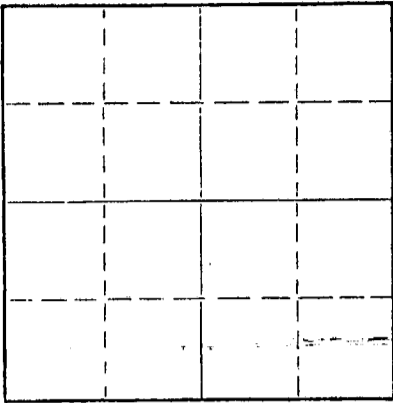

Locate well correctly on above
Section Plat

Saline County. Sec. 31 Twp. 16 Rge. 3 (E) (W)
Location as "NE/CNW/SW" or footage from lines SE SE SE
Lease Owner Don Mc Keller
Lease Name Johnson Well No. I
Office Address 1321 Pershing, Salina, Kansas
Character of Well (completed as Oil, Gas or Dry Hole) Oil
Date well completed II-2 19 61
Application for plugging filed Nov 19 62
Application for plugging approved Nov 19 62
Plugging commenced Nov 16 19 62
Plugging completed Nov 21 19 62
Reason for abandonment of well or producing formation Went Dry.

If a producing well is abandoned, date of last production _____ 19____
Was permission obtained from the Conservation Division or its agents before plugging was commenced? Yes

Name of Conservation Agent who supervised plugging of this well Gilbert Toman
Producing formation _____ Depth to top _____ Bottom _____ Total Depth of Well 3505' Feet
Show depth and thickness of all water, oil and gas formations.

OIL, GAS OR WATER RECORDS

CASING RECORD

FORMATION	CONTENT	FROM	TO	SIZE	PUT IN	PULLED OUT
						2923'

Describe in detail the manner in which the well was plugged, indicating where the mud fluid was placed and the method or methods used in introducing it into the hole. If cement or other plugs were used, state the character of same and depth placed, from _____ feet to _____ feet for each plug set.

Plugged off bottom of hole with rock. Rock from 3380' to 3350'. Dumped 4 sx of cement. Mudded hole to 300'. Made 10' of rock bridge. Dumped 3 1/4 Yrds. of Ready-Mix Cement, filling to the bottom of the celler.

NOV 23 1962
CONSERVATION DIVISION
WICHITA

(If additional description is necessary, use BACK of this sheet)

Name of Plugging Contractor Art Lamb Casing Pulling Co.
Address P.O. Box 983 Hutchinson, Kansas

STATE OF Kansas, COUNTY OF Reno, ss.
Art Lamb (employee of owner) or (owner or operator) of the above-described well, being first duly sworn on oath, says: That I have knowledge of the facts, statements, and matters herein contained and the log of the above-described well as filed and that the same are true and correct. So help me God.

(Signature) [Signature]
2809 Kings Drive Hutchinson, Kansas
(Address)

SUBSCRIBED AND SWORN to before me this 23 rd day of November, 1962
My commission expires January 5, 1966



[Signature]
Notary Public.

15-169-19128-00-00

DON McKELLAR
1321 Pershing
Salina, Kansas

Well: Johnson No. 1
Commenced RD: 10/22/61
Completed RD: 11/ 2/61
Total Depth: 3,505' D.F.
Casing: 346' of 8 5/8" 24# 8 rd. thd.
3505' of 4 1/2" Oil String

Sec. 31-16-3
Saline County, Kansas
Elevation:
Initial Prod:
Contractor: DUKE BURT
DRILLING CO.

Strata	Depth
Post Rock & gyp	0- 40'
Shale & shells	40- 234
Silt	234- 260
Shale & shells	260-346
Anhydrite	346- 349
Shale & shells	349-398
Lime w/ shale streaks	398- 990
Shale & lime	990-2222
Lime w/ shale streaks	2222-2269
Lime (Lansing)	2269-2410
Lime & shale	2410-2489
Lime	2489-2613
Shale w/lime streaks	2613-2670
Lime & shale	2670-2915
Lime (Mississippian)	2915-2930
Lime & chert	2930-3104
Lime	3104-3150
Shale	3150-3378
Maquoketa Dolomite	3378-3412
Lime & shale	3412-3455
Lime (Viola)	3455-3505

RECORDED
STATE CORPORATION COMMISSION
NOV 21 1961
CONSERVATION DIVISION
Wichita, Kansas

I hereby certify that the above is a true and correct log of said well as reflected by daily drilling reports.

DUKE BURT DRILLING CO.

By *Duke Burt*

Signed and sworn to in my presence this 7 day of November, 1961

Jana George

My Commission Expires: August 26, 1965



SE/SE/SE