


Give All Information Completely  
Make Required Affidavit  
Mail or Deliver Report to:  
Conservation Division  
State Corporation Commission  
212 No. Market  
Wichita, Kansas

WELL PLUGGING RECORD

15-169-00602-00-00

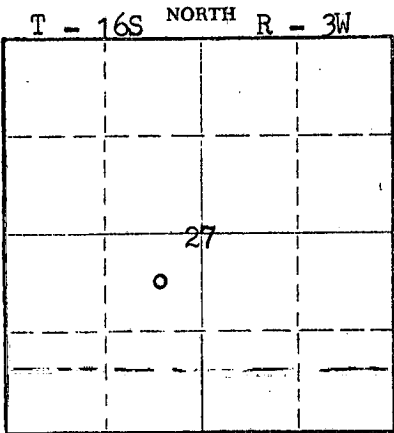

Locate well correctly on above Section Plat

Location as "NE/CNWxSWx" or footage from lines. Saline County. Sec. 29 Twp. 16S Rge. 3 (E) 3 (W)  
C NE SW  
Lease Owner Frank J. Black  
Lease Name Lindshield A Well No. 1  
Office Address Box 150, McPherson, Kansas 67460  
Character of Well (completed as Oil, Gas or Dry Hole) Oil  
Date well completed 7-24-61 1961  
Application for plugging filed 1-15-69 1969  
Application for plugging approved 1-16-69 1969  
Plugging commenced 2/13 k 1969  
Plugging completed 3/1 1969  
Reason for abandonment of well or producing formation Dry

If a producing well is abandoned, date of last production 19  
Was permission obtained from the Conservation Division or its agents before plugging was commenced? Yes

Name of Conservation Agent who supervised plugging of this well Gilbert Tomon  
Producing formation \_\_\_\_\_ Depth to top \_\_\_\_\_ Bottom \_\_\_\_\_ Total Depth of Well 3465 Feet  
Show depth and thickness of all water, oil and gas formations.

OIL, GAS OR WATER RECORDS

CASING RECORD

FORMATION	CONTENT	FROM	TO	SIZE	PUT IN	PULLED OUT
				8-5/8"	251'	None
				5-1/2"	3464'	2905'

Describe in detail the manner in which the well was plugged, indicating where the mud fluid was placed and the method or methods used in introducing it into the hole. If cement or other plugs were used, state the character of same and depth placed, from \_\_\_\_\_ feet to \_\_\_\_\_ feet for each plug set.

Pipe set at 3464 ft. with 75 sacks cement;  
Dumped 75 sacks cement;  
Sanded back to 3450 ft -- put 5 sacks cement  
Set 10 ft. rock bridge at 250 ft;  
~~By~~ Dumped 25 sacks cement;  
Set 10 ft. rock bridge at 40 ft.  
Dumped 10 sacks cement.

RECEIVED  
STATE CORPORATION COMMISSION  
MAR 11 1969  
CONSERVATION DIVISION  
Wichita, Kansas

(If additional description is necessary, use BACK of this sheet)  
Name of Plugging Contractor Ralph Lynch Casing Pulling Co. License #457  
Address RR#4 Great Bend, Kansas

STATE OF KANSAS, COUNTY OF MCPHERSON, ss.  
Frank J. Black (employee of owner) or (owner or contractor) of the above-described wells, being first duly sworn on oath, says: That I have knowledge of the facts, statements, and matters herein contained and the log of the above described well as filed and that the same are true and correct. So help me God.  
(Signature) Frank J. Black  
Box 150, McPherson, Kansas  
(Address)



Subscribed and sworn to before me this 10th day of March, 1969  
My commission expires July 16, 1971  
Jerry Peltzman  
JERRY PELTZMAN Notary Public.

15-169-00602-00-00  
 WELL LOG BUREAU—KANSAS GEOLOGICAL SOCIETY  
 508 East Murdock, Wichita, Kansas


COPY

Company- ROCHWILE, INC.  
 Farm- Lindshield "A" No. 1

SEC. 29 T. 16 R. 3W  
 C NE SW

Total Depth. 3465'  
 Comm. 7-11-61 Comp. 7-24-61  
 Spent or Treated.  
 Contractor. L. B. Jackson Co.  
 Issued. 11-4-61

County Saline  
 KANSAS

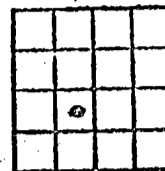

Elevation. 1369' Gr.

CASING:  
 8 5/8" 251' cem w/175 sx.  
 5 1/2" 3464' cem w/75 sx.

Production. 25 BOPD

Figures Indicate Bottom of Formations.

soil	5
shale & lime streak	315
lime & shale	725
lime & shale	1240
grey shale & lime streak	1600
grey shale	1845
lime & shale	2100
shale & lime (grey)	2295
white to buff dolomite	2386
buff lime	2405
buff lime - dolomitic	2460
brown lime	2515
brown lime - dolomitic	2545
brown lime	2580
buff lime - oolitic/oolitic	2600
brown lime	2715
lime & shale (Brown)	2960
brown lime, some grey glassy chert	2990
white weathered chert/white glassy chert	3040
white weathered chert	3135
white to grey lime	3155
brown lime	3180
grey to grey green shale	3408
Maquoketa dolomite	3433
grey dolomite, some grey chert	3465
Total Depth	
TOPS:	
Kansas City-Lansing Lime	2295
Mississippi Lime	2960
Kinderhook Shale	3408

RECEIVED  
 STATE CORPORATION COMMISSION  
 MAR 1 1 1969  
 CONSERVATION DIVISION  
 Wichita, Kansas