


15-169-00702-00-00

WELL PLUGGING RECORD

Give All Information Completely
Make Required Affidavit
Mail or Deliver Report to:
Conservation Division
State Corporation Commission
212 North Market, Insurance Bldg.
Wichita, Kansas

Saline County, Sec. 27 Twp. 16S Rge. (E) 3 (W)
Location as "NE/CNW/SW" or footage from lines NW/4 NW/4 NE/4
Lease Owner J. S. Cling Oil Company
Lease Name Lovett Well No. 1
Office Address 110 1/2 East Kansas, McPherson, Kansas
Character of Well (completed as Oil, Gas or Dry Hole) Dry Hole
Date well completed October 6, 19 60
Application for plugging filed 19
Application for plugging approved 19
Plugging commenced October 6, 19 60
Plugging completed October 6, 19 60
Reason for abandonment of well or producing formation Dry Hole

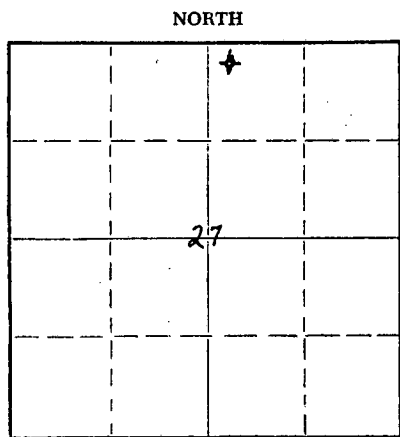

Locate well correctly on above Section Plat

If a producing well is abandoned, date of last production 19
Was permission obtained from the Conservation Division or its agents before plugging was commenced? Yes (verbal)

Name of Conservation Agent who supervised plugging of this well Cecil Jones
Producing formation _____ Depth to top _____ Bottom _____ Total Depth of Well 3376 Feet
Show depth and thickness of all water, oil and gas formations.

OIL, GAS OR WATER RECORDS

CASING RECORD

FORMATION	CONTENT	FROM	TO	SIZE	PUT IN	PULLED OUT
				8-5/8"	323	None

Describe in detail the manner in which the well was plugged, indicating where the mud fluid was placed and the method or methods used in introducing it into the hole. If cement or other plugs were used, state the character of same and depth placed, from _____ feet to _____ feet for each plug set.

From 3376' to 300' w/ heavy mud
From 300' to 300' set wood plug
" 300' to 240' w/ 20 sacks of cement
" 240' to 40' w/ heavy mud
" 40' to 40' set wood plug
" 40' to 35' w/ 5 gallons of crushed rock
" 35' to 5' w/ 10 sacks of cement
" 5' to 0' w/ surface soil

RECEIVED
STATE CORPORATION COMMISSION
NOV 14 1960
CONSERVATION DIVISION
Wichita, Kansas

(If additional description is necessary, use BACK of this sheet)

Name of Plugging Contractor Melland Drilling Company, Inc.
Address 1111 North Main Street, Hutchinson, Kansas

STATE OF Kansas, COUNTY OF McPherson, ss.
J. S. Cling (owner or operator) of the above-described well, being first duly sworn on oath, says: That I have knowledge of the facts, statements, and matters herein contained and the log of the above-described well as filed and that the same are true and correct. So help me God.

(Signature) X J. S. Cling
Box 326, McPherson, Ks.
(Address)

SUBSCRIBED AND SWORN to before me this 10 day of November, 19 60

6/29/61 Eddlene M. Maloy Notary Public.



15-169-00702-00-00

WELL RECORD

LEASE: Lovett

WELL NO. 1

LOCATION: NW/4 NW/4 NE/4
Section 27-16S-3W
Saline County
Kansas

COMMENCED: September 27, 1960
COMPLETED: October 6, 1960
(rotary) as a DRY HOLE

OPERATOR: J. S. Cling Oil Company
110 1/2 East Kansas
McPherson, Kansas

CONTRACTOR: Melland Drilling Company, Inc.
1111 North Main Street
Hutchinson, Kansas

CASING RECORD: Set 8-5/8" OD casing at 323' and cemented with 205 sacks.

<u>FORMATION</u>	<u>LOG</u>
Surface soil, clay and shale	45
Clay and shale	130
Shale, shells & gypsum	240
Anhydrite	323
Anhydrite w/ shale	455
Lime & shale	1200
Shale & lime	1400
Lime & shale	2030
Sandy lime	2065
Sand & shale	2150
Shale & lime	2285
Lime & shale	2535
Shale & lime	2725
Shale w/ shells	2876
Mississippi Lime	3055
Lime	3105
Shale & lime	3185
Shale	3376

RECEIVED
STATE CORPORATION COMMISSION
NOV 14 1960
CONSERVATION DIVISION
Wichita, Kansas

ROTARY TOTAL DEPTH
Plugged back from 3376' to 300' w/
heavy mud; set wood plug at 300' w/
1/2 sacks of hulls; 20 sacks of
cement from 300' to 240'; heavy mud
from 240' to 40'; set wood plug at
40'; 5 gallons of crushed rock from
40' to 35'; 10 sacks of cement from
35' to 5'; surface soil from 5' to
0'. Plugged and abandoned 10:00 a.m.,
10/6/60.