


15-169-00939-00-00
Form CP-4

STATE OF KANSAS
STATE CORPORATION COMMISSION

Give All Information Completely
Make Required Affidavit
Mail or Deliver Report to:
Conservation Division
State Corporation Commission
212 No. Market
Wichita, Kansas

WELL PLUGGING RECORD

NORTH

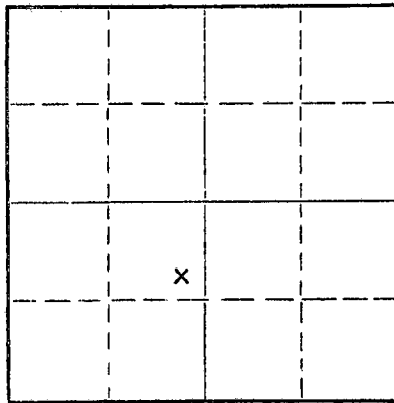

Locate well correctly on above
Section Plat

Saline County, Sec. 20 Twp. 16 Rge. 3 (EX (W))
Location as "NE/CNW/SW" or footage from lines SE 1/4 SW 3/4 Sec
Lease Owner Kirby Petro. Co.
Lease Name Nelson Well No. 2
Office Address 402 First Nat'l Bank Bldg. Pawhuska, Okla.
Character of Well (completed as Oil, Gas or Dry Hole) oil well
Date well completed 10-20-52 19
Application for plugging filed 6-5-67 19
Application for plugging approved 6-6-67 19
Plugging commenced 6-30-67 19
Plugging completed 7-7-67 19
Reason for abandonment of well or producing formation depleted

If a producing well is abandoned, date of last production 19
Was permission obtained from the Conservation Division or its agents before plugging was commenced? yes

Name of Conservation Agent who supervised plugging of this well Gilbert Toman
Producing formation Maquoketa Depth to top 3420 Bottom 3425 Total Depth of Well 3425 Feet
Show depth and thickness of all water, oil and gas formations.

OIL, GAS OR WATER RECORDS

CASING RECORD

FORMATION	CONTENT	FROM	TO	SIZE	PUT IN	PULLED OUT
				12 3/4	152'	none
				8 5/8	400'	none
				5 1/2	3420'	2842

Describe in detail the manner in which the well was plugged, indicating where the mud fluid was placed and the method or methods used in introducing it into the hole. If cement or other plugs were used, state the character of same and depth placed, from feet to feet for each plug set.

Fill hole with chat from 3425' to 3400' and dump 5 sacks of cement
Set 20' rock bridge from 294' and dump 25 sacks of cement
Mud hole to 30', rock from 30' to 25' and dump 15 sacks of cement to surface

RECEIVED
STATE CORPORATION COMMISSION

AUG 4 1967

CONSERVATION DIVISION
Wichita, Kansas

(If additional description is necessary, use BACK of this sheet)

Name of Plugging Contractor Flint Engineering and Const. Co.
Address 2375 W. Central El Dorado, Kansas

STATE OF Kansas, COUNTY OF Butler, ss.
(employee of owner) or (owner or operator) of the above-described well, being first duly sworn on oath, says: That I have knowledge of the facts, statements, and matters herein contained and the log of the above-described well as filed and that the same are true and correct. So help me God.

(Signature) *James Davis*

(Address) _____, 19 67

SUBSCRIBED AND SWORN TO before me this 2 day of August, 19 67

Sept. 27, 1967

Ronald R. Hanson
Notary Public.



15-169-00939-00-00

**NATIONAL ASSOCIATED PETROLEUM COMPANY
NELSON NO. 2
SALINA COUNTY, KANSAS**

**Drilling Contractor: Exploration Drilling Co.
220 North Boston
Tulsa, Oklahoma**

**Started Rigging Up : 10- 3-52
Started Drilling : 10- 9-52
Completed Drilling : 10-20-52**

**Set: 6 Joints of 12 3/4" Surface Casing
@ 152' W/200 Sacks of Cement.**

**Set: 111 Joints of 5 1/2"
Casing @ 3420' W/75
Sacks of Cement.**

**Set: 13 Joints of 8 5/8" Intermediate
Casing @ 400' W/100 Sacks of Cement.**

FORMATIONS

Surface	0'	423'
Shale & Sandy Lime	423	605
Sandy Shale & Lime	605	765
Sand & Lime	765	875
Sandy Lime	875	1020
Shale	1020	1325
Shale & Lime	1325	1535
Shale	1535	1870
Shale & Lime	1870	1985
Lime	1985	2160
Shale & Lime	2160	2382
Dolomite & Lime	2382	2482
Lime	2482	2610
Dolomite & Lime	2610	2653
Lime	2653	2685
Lime & Shale	2685	2745
Lime	2745	2843
Lime & Shale	2843	2943
Shale & Sand	2943	2965
Chert & Cherty Lime	2965	3000
Cherty Lime, Chert & Shale	3000	3064
Lime & Chert	3064	3118
Lime	3118	3188
Lime & Shale	3188	3425 Total Depth

CERTIFICATION

This is to certify that the above and foregoing is a true, correct, and complete copy of the Driller's Log covering the Nelson No. 2 according to the records of this office and the best of my knowledge and belief.

EXPLORATION DRILLING COMPANY

By Gloria M. Kee

Notary Public

Subscribed and sworn to before me this 30th day of October, 1952.

My commission expires April 25, 1954.