
15-169-00030-00-00

STATE OF KANSAS
STATE CORPORATION COMMISSION

Give All Information Completely
Make Required Affidavit
Mail or Deliver Report to:
Conservation Division
State Corporation Commission
800 Bitting Building
Wichita, Kansas

WELL PLUGGING RECORD

NORTH

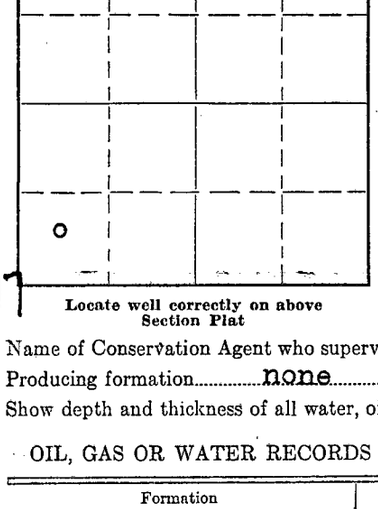

Locate well correctly on above Section Plat

Saline County. Sec. 17 Twp. 16S Rge. 3W (E) (W)

Location as "NE/CNW¼SW¼" or footage from lines C-SW-SW-NE/4

Lease Owner Phillips & Sanderson

Lease Name E. L. Johnson Well No. 1

Office Address 535 State, Salina, Kansas

Character of Well (completed as Oil, Gas or Dry Hole) Dry Hole

Date well completed 11-6-52 19

Application for plugging filed 11-6- 19 52

Application for plugging approved 11-6- 19 52

Plugging commenced 11-6- 19 52

Plugging completed 11-6- 19 52

Reason for abandonment of well or producing formation Dry Hole

If a producing well is abandoned, date of last production 19

Was permission obtained from the Conservation Division or its agents before plugging was commenced? yes

Name of Conservation Agent who supervised plugging of this well Ruel Durkee

Producing formation none Depth to top Bottom Total Depth of Well 3413 Feet

Show depth and thickness of all water, oil and gas formations.

OIL, GAS OR WATER RECORDS — CASING RECORD

Formation	Content	From	To	Size	Put In	Pulled Out
Maquoketa Dolomite	Dry	3388'	3413'	8-5/8	310'	none

Describe in detail the manner in which the well was plugged, indicating where the mud fluid was placed and the method or methods used in introducing it into the hole. If cement or other plugs were used, state the character of same and depth placed, from feet to feet for each plug set.

Set wood plug at 190'
Cemented with 15sx
Mud from 190' to 30'
Set wood plug at 30'
Cemented with 5sx to
cellar floor.

RECEIVED
STATE CORPORATION COMMISSION
NOV 17 1952
CONSERVATION DIVISION
Wichita, Kansas

(If additional description is necessary, use BACK of this sheet)

Name of Plugging Contractor E. K. Carey Drilling Contractor

Address McPherson, Kansas

STATE OF Kansas, COUNTY OF Saline, ss.

T. A. Phillips (employee of owner) or (owner or operator) of the above-described well, being first duly sworn on oath, says: That I have knowledge of the facts, statements, and matters herein contained and the log of the above-described well as filed and that the same are true and correct. So help me God.

(Signature) T. A. Phillips

535 State St., Salina, Kansas
(Address)

SUBSCRIBED AND SWORN TO before me this 10th day of November, 1952

A. B. Dodge Jr.
Notary Public.

My commission expires April 12, 1956

23-8390-s 6-51—20M

PLUGGING
FILE SEC 17 T 16 R 3W
BOOK PAGE 52 LINE 44

15-169-00030-00-00

ROTARY DRILLER'S LOG

Phillips & Sanderson
535 State Street
Salina, Kansas

Elevation: 1356 K. B.
1353 D. F.

Casing Record:

E. Johnson #1

8-5/8" Csg. 310' w/260 sx.

SW SW NE/4
Sec. 17-16-3W
Saline County, Kansas

Well commenced: 10-23-52
Well completed: 11- 6-52

Contractor: E. K. Carey Contractor, Rig #1 Box 620, McPherson, Kansas
Geologist: Don Smith, 5206 E. Central, Wichita, Kansas

Figures Indicate Bottom of Formation K. B.

Base & cellar	8
Clay	68
Shale & Shells	262
Lime & shale	865
Lime	1000
Lime & shale	1185
Shale & lime	1630
Lime & shale	1835
Lime	2130
Shale & lime	2190
Lime & shale	2295
Lime	2750
Lime & shale	2790
Shale & lime	2835
Shale	2930
Lime	3160
Shale & lime	3230
Shale	3388
Lime	3413 TD

Geologist Tops:

Tops will be shown Geological report.

D. S. T. 3389 - 3413 with 24' anchor. Tool open 1 hr. 15 min BHP 60#, recovered 15' rotary mud with slight oil stains on top. Test started with weak blow and died out in 12 minutes.

RECEIVED
STATE CORPORATION COMMISSION
NOV 12 1952
CONSERVATION DIVISION
Wichita, Kansas

PLUGGING
FILE SEC 17 T 16 R 3W
BOOK PAGE 67 LINE 44

15-169-00036-00-00

ROTARY DRILLER'S LOG

Phillips & Sanderson
535 E State Street
Salina, Kansas

E. Johnson #1

SW SW NE/4
Sec. 17-16-3W
Saline County, Kansas

Well Commenced: 10-23-52
Well Completed: 11- 6-52

Elevation: 1356 K. B.
1353 D. F.

Casing Record:

8-5/8" Csg. 310' w/260 sx.

Contractor: E. K. Carey Contractor, Rig #1, Box 620, McPherson, Kansas
Geologist: Don Smith, 5206 E. Central, Wichita, Kansas

Figures Indicate Bottom of Formation K. B.

Base & cellar	8	Geologist Tops:
Clay	68	
Shale & shells	262	Tops will be shown Geological
Lime & shale	865	report.
Lime	1000	
Lime & shale	1185	D. S. T. 3389 - 3413 with 24'
Shale & lime	1630	anchor. Tool open 1 hr. 15 min.
Lime & shale	1835	BHP 60#, recovered 15' rotary
Lime	2130	mud with slight oil stain on top.
Shale & lime	2190	Test started with weak blow and
Lime & shale	2295	died out in 12 minutes.
Lime	2750	
Lime & shale	2790	
Shale & lime	2835	Well D & A 11-6-52
Shale	2930	
Lime	3160	
Shale & lime	3230	
Shale	3388	
Lime	3413 TD	

This is to certify that the above information is to the best of my knowledge true and correct.

Subscribed and Sworn to before me this 7th day of November 1952.

E. K. CAREY CONTRACTOR

By Herbert Rhoton
Herbert Rhoton, Superintendent

A. C. Snider
NOTARY PUBLIC
McPherson County

A. C. Snider NP

My Commission Expires November 13, 1952

RECEIVED
STATE CORPORATION COMMISSION
NOV 12 1952
CONSERVATION DIVISION
Wichita, Kansas