


Give All Information Completely  
Make Required Affidavit  
Mail or Deliver Report to:  
Conservation Division  
State Corporation Commission  
212 North Market, Insurance Bldg.  
Wichita, Kansas

15-135-00172-00-00  
**WELL PLUGGING RECORD**

Ness County, Sec. 14 Twp. 16S Rge. (E) 25W (W)

Location as "NE/CNW/SW" or footage from lines Cen SW/4 NW/4  
Lease Owner Birmingham-Bartlett Drilling Co.  
Lease Name Huxman "C" Well No. 1  
Office Address 300 Kaufman Building, Wichita 2, Kansas  
Character of Well (completed as Oil, Gas or Dry Hole) Dry Hole  
Date well completed January 21, 1961  
Application for plugging filed February 1, 1961  
Application for plugging approved February 2, 1961  
Plugging commenced February 9, 1961  
Plugging completed February 22, 1961  
Reason for abandonment of well or producing formation Dry Hole

NORTH

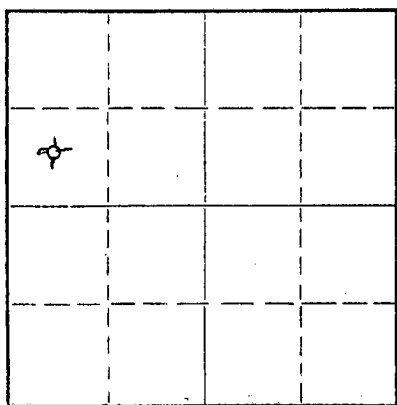

Locate well correctly on above Section Plat

If a producing well is abandoned, date of last production -- 1961  
Was permission obtained from the Conservation Division or its agents before plugging was commenced? Yes

Name of Conservation Agent who supervised plugging of this well Gilbert Leiker

Producing formation \_\_\_\_\_ Depth to top \_\_\_\_\_ Bottom \_\_\_\_\_ Total Depth of Well 4544 Feet  
Show depth and thickness of all water, oil and gas formations.

OIL, GAS OR WATER RECORDS

CASING RECORD

FORMATION	CONTENT	FROM	TO	SIZE	PUT IN	PULLED OUT
		0	256'	8-5/8"	256'	None
		0	4527'	5-1/2"	4527'	3518'

Describe in detail the manner in which the well was plugged, indicating where the mud fluid was placed and the method or methods used in introducing it into the hole. If cement or other plugs were used, state the character of same and depth placed, from \_\_\_\_\_ feet to \_\_\_\_\_ feet for each plug set.

Plugged back with sand from 4472' to 4460'. Mixed and dumped 4 sx. cement from 4460' to 4428'. Pulled casing. Mudded hole to 302'. Set 10' rock bridge from 302' to 292'. Mixed and dumped 20 sx. cement from 292' to 232'. Mudded hole from 232'. ##### to 40'. Set 10' rock bridge from 40' to 30'. Mixed and dumped 10 sx. cement from 30' to base cellar.

**RECEIVED**  
STATE CORPORATION COMMISSION  
MAR 7 1961  
CONSERVATION DIVISION  
Wichita, Kansas

(If additional description is necessary, use BACK of this sheet)

Name of Plugging Contractor Ace Pipe Pulling Co.  
Address Box 304 Great Bend, Ka.

STATE OF KANSAS, COUNTY OF SEDGWICK  
Chas. H. Keevert, Prod. Supt. of Birmingham, Bartlett Drilling Co. ss.  
(employee of owner) or (owner or operator) of the above-described well, being first duly sworn on oath, says: That I have knowledge of the facts, statements, and matters herein contained and the log of the above-described well as filed and that the same are true and correct. So help me God.

(Signature) Chas. H. Keevert  
Wilson Road, Route 1, Hutchinson, Kansas  
(Address)

SUBSCRIBED AND SWORN to before me this 7th day of March, 1961.

Vivian F. Yinger  
Vivian F. Yinger, Notary Public.

My commission expires November 29, 1962.



HUXMAN "C" NO. 1 WELL

LOCATION: C - SW/4 NW/4  
Section 14-168-25W  
Ness County, Kansas

SPUDED: 12-30-60  
COMPLETED: 1-10-61

OWNER, OPERATOR  
and CONTRACTOR: Birmingham-Bartlett Drilling Co.  
300 Kaufman Building  
Wichita 2, Kansas

SURFACE CASING: 8-5/8" cemented at 256' with  
175 sacks cement.

OIL STRING: 5-1/2" OD 14# J-55-R-3-smls.  
casing cemented at 4527' with  
100 sacks common cement.

LOG

(Figures indicate bottom of formation)

0 -	30	Clay
	120	Sand
	256	Shale and shells
	760	Shale
	950	Sand
	1348	Shale and red bed
	1793	Shale and shells
	1950	Red bed
	1986	Stone corral, Anhydrite
	2545	Shale and shells
	2960	Lime and shale
	3060	Shale and shells
	3790	Shale and lime
	3958	Lime
	4050	Lime and chert
	4470	Lime
	4525	Lime and shale
	4537	Lime
	4537	Rotary total depth

The undersigned, Richard Hindery, one of the partners of Birmingham-Bartlett Drilling Co., hereby certifies that the above is a true and correct log of the Huxman "C" No. 1 Well as shown in the daily drilling reports.

BIRMINGHAM-BARTLETT DRILLING CO.

By Richard Hindery  
Richard Hindery, Partner

Subscribed and sworn to before me  
this 12th day of January, 1961.

Beverly Larson

Beverly Larson, Notary Public  
My commission expires October 2, 1962.