

15-135-20537-00-00

STATE OF KANSAS
STATE CORPORATION COMMISSION

Form CP-4


Give All Information Completely
Make Required Affidavit
Mail or Deliver Report to:
Conservation Division
State Corporation Commission
211 No. Broadway
Wichita, Kansas

WELL PLUGGING RECORD

Ness County. Sec. 18 Twp. 16S Rge. 25W (E) (W)

Location as "NE/CNW/SW" or footage from lines. SW NE
Lease Owner Thunderbird Drilling, Inc.
Lease Name Evel 'B' Well No. 1
Office Address 4328 E. Kellogg, Wichita, Kansas 67218
Character of Well (completed as Oil, Gas or Dry Hole) Dry Hole
Date well completed January 1 1972
Application for plugging filed January 1 1972
Application for plugging approved January 1 1972
Plugging commenced January 1 1972
Plugging completed January 1 1972
Reason for abandonment of well or producing formation Dry Hole

NORTH

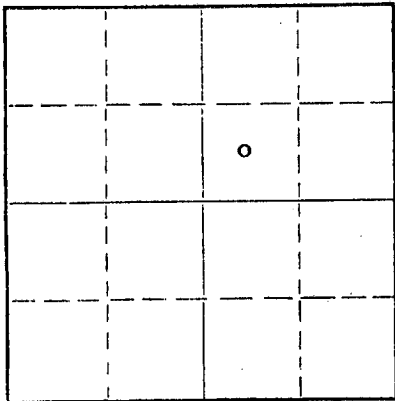

Locate well correctly on above
Section Plat

If a producing well is abandoned, date of last production _____ 19____
Was permission obtained from the Conservation Division or its agents before plugging was commenced? Yes

Name of Conservation Agent who supervised plugging of this well Leo F. Massey, Hays, Kansas 67601
Producing formation _____ Depth to top _____ Bottom _____ Total Depth of Well 4484 Feet
Show depth and thickness of all water, oil and gas formations.

OIL, GAS OR WATER RECORDS

CASING RECORD

FORMATION	CONTENT	FROM	TO	SIZE	PUT IN	PULLED OUT
		0	331'	8 5/8"	331'	None

Describe in detail the manner in which the well was plugged, indicating where the mud fluid was placed and the method or methods used in introducing it into the hole. If cement or other plugs were used, state the character of same and depth placed, from _____ feet to _____ feet for each plug set.

Plug: 800' w/70 sacks cement
300' w/20 sacks cement
40' w/10 sacks cement

RECEIVED
STATE CORPORATION COMMISSION
JAN 6 1972
CONSERVATION DIVISION
Wichita, Kansas

(If additional description is necessary, use BACK of this sheet)

Name of Plugging Contractor Hellar Drilling Company, Inc.
Address 339 Union Center Bldg., Wichita, Kansas 67202


STATE OF Kansas, COUNTY OF Sedgwick, ss.

D. L. Hellar, President of Hellar Drlg. Co. (employee of owner) or (owner or operator) of the above-described well, being first duly sworn on oath, says: That I have knowledge of the facts, statements, and matters herein contained and the log of the above-described well as filed and that the same are true and correct. So help me God.

(Signature) D. L. Hellar D. L. Hellar, President
339 Union Center Bldg., Wichita, Kansas 67202
(Address)

SUBSCRIBED AND SWORN to before me this 5th day of January, 19 72
March 25, 1972.

Catherine Darcey
Catherine Darcey - Notary Public.

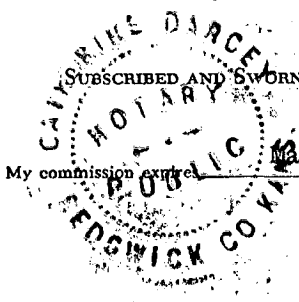

DRILLER'S LOG

COMPANY: Thunderbird Drilling, Inc., 4328 E. Kellogg, Wichita, Kansas 67218
 CONTRACTOR: Hellar Drilling Company, Inc., Wichita, Kansas 67202
 LEASE: #1 Evel 'B'
 LOCATION: SW NE 18-16S-25W, Ness County, Kansas
 COMMENCED: December 19, 1971
 COMPLETED: January 1, 1972
 CASING: Set 8 5/8" Surface Casing @ 331' w/230 sacks cement

0-331	Surface Soil & Post Rock & Sand
331-360	Shale
360-1310	Shale - Sand & Red Bed
1310-1323	Blaine Anhydrite
1323-1742	Cedar Hills Sand
1742-1938	Shale - Red Bed
1938-1974	Anhydrite
1974-2095	Shale & Shells
2095-2230	Shale & Red Bed
2230-2415	Shale
2415-2510	Shale & Lime
2510-2630	Lime & Shale
2630-2775	Lime & Shale Ft. Riley Section
2775-3000	Lime
3000-3845	Lime & Shale
3845-4183	Lime
4183-4263	Lime & Shale
4263-4457	Lime
4457-4470	Miss.
4470-4484	Lime
4484	Rotary Total Depth

D & A

RECEIVED
 STATE CORPORATION COMMISSION
 JAN 6 1972
 CONSERVATION DIVISION
 Wichita, Kansas

STATE OF KANSAS)
) SS
 COUNTY OF SEDGWICK)

I, D. L. Hellar, do hereby certify that the above and foregoing is a true and correct copy of the log of the #1 Evel 'B', located in SW NE 18-16S-25W, Ness County, Kansas as reflected by the files of the Hellar Drilling Company, Inc.

HELLAR DRILLING COMPANY, INC.

By *D. L. Hellar*
 President - D. L. Hellar

Subscribed and sworn to before me, a Notary Public, in and for Sedgwick County, Kansas, this 5th day of January 1972.

Notary Public Seal: CATHERINE DARCEY, NOTARY PUBLIC, SEDGWICK COUNTY, KANSAS. My Commission Expires: March 25, 1972.

Catherine Darcey
 Notary Public - Catherine Darcey