

15-169-00029-00-00

STATE OF KANSAS  
STATE CORPORATION COMMISSION

WELL PLUGGING RECORD

Give All Information Completely  
Make Required Affidavit  
Mail or Deliver Report to:  
Conservation Division  
State Corporation Commission  
800 Bittling Building  
Wichita, Kansas

Saline County, Sec. 10 Twp. 16 Rge. 3 ~~XX~~ (W)

Location as "NE/CNW $\frac{1}{4}$ /SW $\frac{1}{4}$ " or footage from lines C, NE NE SW $\frac{1}{4}$

Lease Owner Phillips & Sanderson

Lease Name Esther Tehlander Well No. 1

Office Address 535 State St. Salina, Kansas

Character of Well (completed as Oil, Gas or Dry Hole) Dry Hole

Date well completed December 11, 1952

Application for plugging filed " 10, 1952

Application for plugging approved " 10, 1952


Plugging commenced 9 P.M. " 10, 1952

Plugging completed " 11, 1952

Reason for abandonment of well or producing formation... Not Productive  
in either Viola Maquoketa or Crystline

If a producing well is abandoned, date of last production 19

Was permission obtained from the Conservation Division or its agents before plugging was commenced? Yes

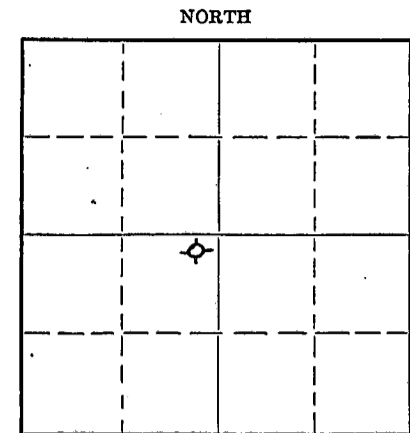

Locate well correctly on above Section Plat

Name of Conservation Agent who supervised plugging of this well Ruel Durkee

Producing formation Depth to top Bottom Total Depth of Well 3377 Feet

Show depth and thickness of all water, oil and gas formations.

OIL, GAS OR WATER RECORDS

CASING RECORD

Formation	Content	From	To	Size	Put In	Pulled Out
Viola	Nothing	3287	3377	8-5/8	315'	None

Describe in detail the manner in which the well was plugged, indicating where the mud fluid was placed and the method or methods used in introducing it into the hole. If cement or other plugs were used, state the character of same and depth placed, from feet to feet for each plug set.

Gunned pits and circulated heavy mud on bottom and again at half way out of hole with drill pipe.

Place solid rock bridge at 190' and then displace 15 sacks cement through 6 joints of drill pipe on top of this rock bridge. Fill with mud to 15' below cellar floor and 5 sacks cement to bottom of cellar floor.

RECEIVED  
STATE CORPORATION COMMISSION

DEC 15 1952

CONSERVATION DIVISION

(If additional description is necessary, use BACK of this sheet) Wichita, Kansas

Correspondence regarding this well should be addressed to T. A. Phillips  
Address 535 State Street, Salina, Kansas

STATE OF Kansas, COUNTY OF McPherson, ss.

Elmer Rider (employee of owner) or (owner or operator) of the above-described well, being first duly sworn on oath, says: That I have knowledge of the facts, statements, and matters herein contained and the log of the above-described well as filed and that the same are true and correct. So help me God.

(Signature) Elmer Rider

212 E. Ave. "F", McPherson, Kansas (Address)

SUBSCRIBED AND SWORN to before me this 12th day of December, 1952

My commission expires November 13, 1956 Notary Public.

28-5091-s 8-50-10M



PLUGGING  
FILE SEC 10 T 16 R 3 24  
BOOK PAGE 65 LINE 30

ROTARY DRILLER'S LOG

15-169-00029-00-00

Phillips & Sanderson  
535 State Street  
Salina, Kansas

Elevation:

Tehlander #1

Casing Record:

C, NE NE SW/4  
Sec. 10-16-3W  
Saline County, Kansas

8-5/8" Csg. 315' W/250 ex.

Well Commenced: 11-22-52  
Well Completed: 12-11-52

Contractor: E. K. Carey Contractor (Rig #1) Box 620, McPherson, Kansas  
Geologist: Lon H. Smith, 5206 S. Central, Wichita 3, Kansas

Figures Indicate Bottom of Formation K.S.

Base & cellar	8
Clay	18
Sand & clay	45
Shale & shells	265
Lime	755
Lime & shale	950
Shale & lime	1735
Lime	2015
Shale & lime	2225
Lime	2585
Lime & shale	2710
Shale & lime	2845
Lime	3064
Shale & lime	3075
Shale	3287
Lime	3377 T.D.

Geologist Tops:

To be furnished by Geologist on his reports.

Well D & A

This is to certify that the above information is to the best of my knowledge true and correct.

SUBSCRIBED AND SWORN to before me this 12th day of December, 19 52

E. K. CAREY, CONTRACTOR

BY Herbert Rhoton  
Herbert Rhoton, Superintendent

[Signature]  
112



My Commission Expires. November 15, 1953

**PLUGGING**  
FILE SEC 10-16-3W  
BOOK PAGE 65 LINE 30