


15-169-00725-00-00

STATE OF KANSAS  
STATE CORPORATION COMMISSION

WELL PLUGGING RECORD

Give All Information Completely  
Make Required Affidavit  
Mail or Deliver Report to:  
Conservation Division  
State Corporation Commission  
800 Bitting Building  
Wichita, Kansas

NORTH

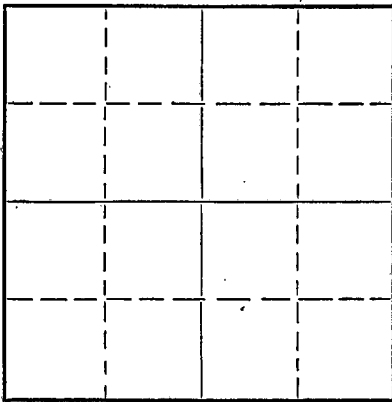

Locate well correctly on above  
Section Plat

Saline County. Sec. 11 Twp. 16S Rge. 3 (E) (W)  
Location as "NE/CNW $\frac{1}{4}$ SW $\frac{1}{4}$ " or footage from lines SW $\frac{1}{4}$  NE $\frac{1}{4}$  NE $\frac{1}{4}$   
Lease Owner Mr. Charles Sheldon  
Lease Name Olsson Well No. 3  
Office Address 425 West Iron, Salina, Kansas  
Character of Well (completed as Oil, Gas or Dry Hole) Dry Hole  
Date well completed December 27 19 50  
Application for plugging filed December 27 19 50  
Application for plugging approved December 27 19 50  
Plugging commenced December 28 19 50  
Plugging completed December 28 19 50  
Reason for abandonment of well or producing formation Dry Hole

If a producing well is abandoned, date of last production 19  
Was permission obtained from the Conservation Division or its agents before plugging was commenced? Yes.

Name of Conservation Agent who supervised plugging of this well Mr. Ruel E. Durkee  
Producing formation Depth to top Bottom Total Depth of Well 3468 Feet  
Show depth and thickness of all water, oil and gas formations.


OIL, GAS OR WATER RECORDS

CASING RECORD

Formation	Content	From	To	Size	Put In	Pulled Out
				13"	150'	
				8-5/8"	292'	

Describe in detail the manner in which the well was plugged, indicating where the mud fluid was placed and the method or methods used in introducing it into the hole. If cement or other plugs were used, state the character of same and depth placed, from feet to feet for each plug set.

Gun pits for heavy mud. Came half way out of hole; gunned pits. Circulated heavy mud 30 minutes. Set plug at 160' and 15 sacks of cement through drill pipe. Filled hole with heavy mud to within 25' of top. 10 Sacks of cement.

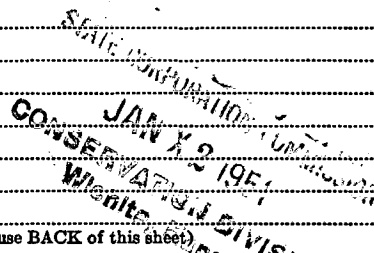

(If additional description is necessary, use BACK of this sheet)

Correspondence regarding this well should be addressed to Sterling Drilling Company  
Address Sterling, Kansas


STATE OF Kansas, COUNTY OF Rice, ss.  
Rollin Mead (employee of owner) or (owner or operator) of the above-described well, being first duly sworn on oath, says: That I have knowledge of the facts, statements, and matters herein contained and the log of the above-described well as filed and that the same are true and correct. So help me God.

(Signature) Rollin Mead - President  
Sterling, Kansas (Address)

SUBSCRIBED AND SWORN to before me this 30th day of December, 1950

My commission expires 9-17-53

28-5091-s 8-50-10M  
PLUGGING  
FILE SEC 11 T 16 R 30  
BOOK PAGE 58 LINE 45

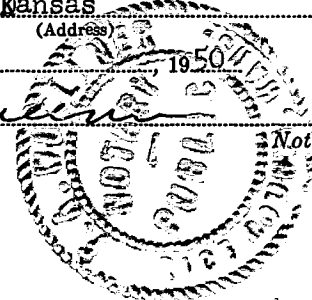

15-169-00725-00-00

# STERLING DRILLING CO.

STERLING, KANSAS

WELL LOG ----- OLSSON #3

Location - SW/4 NE/4 NE/4 of Section 11-16S-3W, Saline County, Kansas

Owner - Mr. Charles Sheldon  
Contractor - Sterling Drilling Company

Commenced - 12-15-50  
Completed - 12-27-50

Total Depth - 3468'

### LOG

0- 70	Soil and Sand
70- 280	Shale and Shells
280- 291	Anhydrite
291- 350	Lime
350-1255	Lime and Shale
1255-1835	Shale and Shells
1835-2530	Lime and Shale
2530-2655	Lime
2655-2890	Lime and Shale
2890-2990	Lime
2990-3055	Cherty Lime
3055-3100	Lime
3100-3310	Shale
3310-3345	Lime
3345-3405	Shale (Lime 3403)
3405-3468	Lime

### CASING RECORD

150' (R.K.B.) of 13" Surface Pipe  
Cemented with 250 Sacks Atlas Cement  
(400# Calcium Chloride, 400# Cal Seal

292' of 8-5/8" Spiral Weld Surface  
Cemented with 75 Sacks Cement  
(2 Sacks Cal Seal)  
Cemented with 175 Sacks thro 1" pipe  
Spotted 7 Sacks Cal Seal @ 230'  
w/1" pipe. Spotted 10 Sacks  
Cement @ 210' 3/1".  
Ran 100 Sacks Cement thro 1" pipe.  
Cemented 8-5/8" from 210' to bottom  
of cellar. Cement circulated  
and held.

**PLUGGING**  
FILE SEC 11 T 16 R 3W  
BOOK PAGE 57 LINE 45

**RECEIVED**  
STATE CORPORATION COMMISSIONER  
JAN X 2 1951  
CONSERVATION DIVISION  
Wichita, Kansas