


Give All Information Completely
Make Required Affidavit
Mail or Deliver Report to:
Conservation Division
State Corporation Commission
800 Bitting Building
Wichita, Kansas

15-169-00724-00-00
WELL PLUGGING RECORD

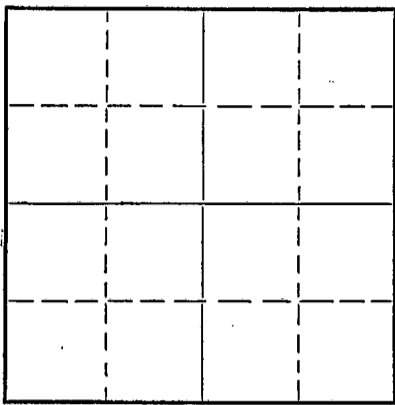

Locate well correctly on above Section Plat

Saline County. Sec. 11 Twp. 16S Rge. 3 (E) W (W)
Location as "NE/CNW $\frac{1}{4}$ SW $\frac{1}{4}$ " or footage from lines NW NW NW
Lease Owner R.J. Laubengayer, Frank Busboom and J.H. Rauh
Lease Name Salina Building Company Well No. 3
Office Address Journal Building, Salina, Kansas
Character of Well (completed as Oil, Gas or Dry Hole) Dry Hole
Date well completed October 9 1951
Application for plugging filed October 9 1951
Application for plugging approved October 9 1951
Plugging commenced October 9 1951
Plugging completed October 9 1951
Reason for abandonment of well or producing formation Dry Hole

If a producing well is abandoned, date of last production 19...
Was permission obtained from the Conservation Division or its agents before plugging was commenced? Yes

Name of Conservation Agent who supervised plugging of this well Ruall Durkee
Producing formation... Depth to top... Bottom... Total Depth of Well 3530 Feet
Show depth and thickness of all water, oil and gas formations.

OIL, GAS OR WATER RECORDS

CASING RECORD

Formation	Content	From	To	Size	Put In	Pulled Out
				13 3/8	96'4"	none
				8 5/8	302	none

Describe in detail the manner in which the well was plugged, indicating where the mud fluid was placed and the method or methods used in introducing it into the hole. If cement or other plugs were used, state the character of same and depth placed, from... feet to... feet for each plug set.

Gunned pits - Circulated heavy mud

Set one plug at 160' cemented with 15 sacks

hand mixed cement - filled with heavy mud to 15'

set one plug at 15' cemented with 5 sacks hand mixed cement to top of hole

OCT 12 1951
CONSERVATION DIVISION
Wichita, Kansas

(If additional description is necessary, use BACK of this sheet)

Correspondence regarding this well should be addressed to R.J. Laubengayer
Address Journal Building, Salina, Kansas

STATE OF Kansas, COUNTY OF Barton, ss.
C.L. Miles (employee of owner) or (owner or operator) of the above-described well,
being first duly sworn on oath, says: That I have knowledge of the facts, statements, and matters herein contained and the log of the above-described well as filed and that the same are true and correct. So help me God.

(Signature) *C. L. Miles*

Great Bend, Kansas

(Address)

SUBSCRIBED AND SWORN to before me this 11th day of October, 1951

Kenneth L. Fischer
Notary Public.



PLUGGING
FILE SEC 11 T 16 R 32
BOOK PAGE 116 LINE 15

DRILLER'S LOG

Company: Laubengayer, Busboom and Rauh

Sec. 11-16S-3W

Farm: Salina Building Co. No: 3

Log. NE NW NW
Saline County, Kans.

Total Depth: 3530

Comm: 9-26-51

Comp: 10-9-51

Contractor: Honaker Drilling Co., Inc.

Casing: 13 3/8" 93'
8 5/8" 298'

Elevation: 1295 D F
1292 Gr.

Production: D and A

Figures indicate bottom of formations

25	Top Soil and Clay	Cemented 13 3/8" casing at 93'
50	Sand	with 100 sacks
240	Shale and Shells	Cemented around 13 3/8" with
375	Anhydrite	50 sacks
435	Shale and Shells	Cemented 8 5/8" casing at 298'
440	Red Bed	with 150 sacks
715	Shale and Lime	
745	Lime	
1100	Lime and Shale	
1390	Shale, Shells and Salt	
2860	Lime and Shale	
3012	Lime	
3027	Lime and Shale	
3070	Lime	
3387	Lime and Shale	
3460	Lime	
3530	Lime and Shale T.D.	

I CERTIFY THAT THIS IS THE TRUE AND CORRECT COPY OF THE ABOVE LOG,
TO THE BEST OF MY KNOWLEDGE.

Joe J. Honaker

Subscribed and sworn to before me this 11 day of October 1951

Frank L. Fischer
Notary Public

My Commission Expires 6-25-55

11-16-3W
11-16-15