


STATE OF KANSAS
STATE CORPORATION COMMISSION

WELL PLUGGING RECORD

Give All Information Completely
Make Required Affidavit
Mail or Deliver Report to
Conservation Division
State Corporation Comm.
245 North Water
Wichita, KS 67202

Ness County, Sec. 25 Twp. 16S Rge. 25W E/W
Location as "NE/CNW $\frac{1}{4}$ /SW $\frac{1}{4}$ " or footage from lines
SE NE SW

Lease Owner Palomino Petroleum
Lease Name Flax Well No. #2
Office Address P. O. Box 18610, Wichita, Kansas 67218
Character of Well (Completed as Oil, Gas or Dry Hole) dry hole

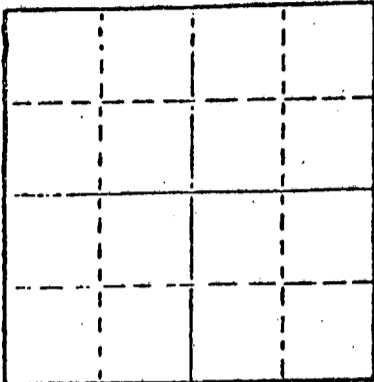

Locate well correctly on above
Section Plot

Date Well completed November 17, 1980 19
Application for plugging filed November 17, 1980 19
Application for plugging approved November 17, 1980 19
Plugging commenced November 17, 1980 19
Plugging completed November 17, 1980 19
Reason for abandonment of well or producing formation dry hole

If a producing well is abandoned, date of last production 19

Was permission obtained from the Conservation Division or its agents before plugging was commenced? yes

Name of Conservation Agent who supervised plugging of this well Marion Schmidt
Producing formation Depth to top Bottom Total Depth of Well 4533'
Show depth and thickness of all water, oil and gas formations.

OIL, GAS OR WATER RECORDS

CASING RECORD

FORMATION	CONTENT	FROM	TO	SIZE	PUT IN	PULLED OUT

Describe in detail the manner in which the well was plugged, indicating where the mud fluid was placed and the method or methods used in introducing it into the hold. If cement or other plugs were used, state the character of same and depth placed, from feet to feet for each plug set.

Hole plugged with 50-50 pozmix, 6% gel, as follows:
70 sacks @ 1200', 25 sacks @ 270', hulls and 10
sacks @ 40', 3 sacks in rathole, 2 sacks in mousehole.

(If additional description is necessary, use BACK of this report)

Name of Plugging Contractor Strata Drilling Company

12-12-80
CONSERVATION DIVISION
Wichita, Kansas


STATE OF Kansas COUNTY OF Barton, ss.
Charles W. Steincamp (employee of owner) or (owner or operator)
of the above-described well, being first duly sworn on oath, says: That I have knowledge of the facts, statements, and matters herein contained and the log of the above-described well as filed and that the same are true and correct. So help me God.

(Signature) Charles W. Steincamp
P. O. Box 355, Great Bend, Kansas 67530
(Address)

SUBSCRIBED AND SWORN TO before me this 21st day of November, 1980

Loneita Barry
Loneita Barry Notary Public.

My commission expires 3-28-84.

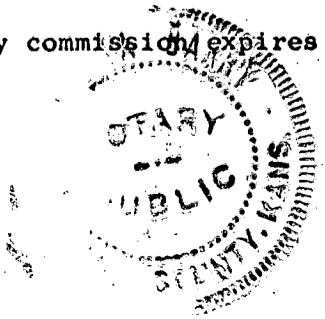

DRILLERS LOG

#2 Flax

CASING RECORD:
7 jts. new 8-5/8"
surface casing

COMPANY: Palomino Petroleum
CONTRACTOR: Strata Drilling Company
COMMENCED: November 11, 1980
COMPLETED: November 17, 1980

DESCRIPTION: SE NE SW
Section 25-16S-25W
Ness County, Kansas
ELEVATION: 2522' KB

TOTAL ROTARY
DEPTH: 4533'

D & A

<u>FORMATION</u>	<u>FROM</u>	<u>TO</u>	<u>REMARKS</u>	
Surface soil, shale	0	290	Ran 277' new 23# 8-5/8" surface casing; set and cemented at 282' with 180 sacks common cement, 2% gel, 3% C.C. Cement circulated. Plug down at 8:30 p.m., November 11, 1980.	
Shale and sand, shale	290	1885		
Anhydrite	1885	1917		
Shale	1917	2500		
Lime and shale	2500	2805		
Lime	2805	3080		
Lime and shale	3080	4475		
Lime	4475	4533		
				Ran 1 drill stem test.
				Hole plugged with 50-50 pozmix, 6% gel, as follows: 70 sacks @ 1200', 25 sacks @ 270', hulls and 10 sacks @ 40', 3 sacks in rathole, 2 sacks in mousehole. Plugging completed at 2:15 p.m., November 17, 1980.

STATE OF KANSAS)
)ss
COUNTY OF BARTON)

RECEIVED
DECEMBER 12 1980
12-12-80
CONSERVATION DIVISION
Wichita, Kansas

I certify that this is a true and correct copy of the above log to the best of my knowledge.

STRATA DRILLING COMPANY

Charles W. Steincamp
Charles W. Steincamp

Sworn to and subscribed before me this 21st day of November, 1980.

My appointment expires 3-24-84.

Loneita Barry
Loneita Barry, Notary Public

