

STATE OF KANSAS
STATE CORPORATION COMMISSION

WELL PLUGGING RECORD

OR

FORMATION PLUGGING RECORD

Strike out upper line
when reporting plugging
off formations.

Give All Information Completely
Make Required Affidavit
Mail or Deliver Report to:
Conservation Division
State Corporation Commission
800 Bitting Building
Wichita, Kansas

County Sec. 25 Twp. 26 Rge. (E) 25 (W)

Location as "NE 1/4 NW 1/4 SW 1/4" or footage from lines 17, 18, 19

Lease Owner J.W. SULLIVAN & FARMER, INC.

Lease Name GREG Well No. 1

Office Address HASKELL

Character of Well (completed as Oil, Gas or Dry Hole) Dry Hole

Date well completed 7/22/48 19

Application for plugging filed 7/22/48 19

Application for plugging approved 7/22/48 19


Plugging commenced 7/22/48 19

Plugging completed 7/22/48 19

Reason for abandonment of well or producing formation Dry Hole

If a producing well is abandoned, date of last production Never Produced 19

Was permission obtained from the Conservation Division or its agents before plugging was commenced? Yes

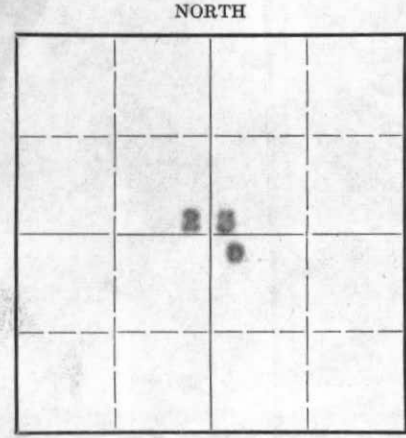

Locate well correctly on above
Section Plat

Name of Conservation Agent who supervised plugging of this well C. D. STUBBS

Producing formation None Depth to top Bottom Total Depth of Well 2620 Feet

Show depth and thickness of all water, oil and gas formations.

OIL, GAS OR WATER RECORDS

CASING RECORD

Formation	Content	From	To	Size	Put In	Pulled Out
Notary Hole - None definitely detected.						

Describe in detail the manner in which the well was plugged, indicating where the mud fluid was placed and the method or methods used in introducing it into the hold. If cement or other plugs were used, state the character of same and depth placed, from feet to feet for each plug set.

- 1. Hole was filled to bottom with heavy mud.
- 2. wooden plug placed at bottom of surface pipe 225'.
- 3. 10 sacks cement mixed and spotted on top of plug.
- 4. Hole filled to within 50' of top with heavy mud.
- 5. 10 sacks cement mixed and dumped in hole - filling same to top.



(If additional description is necessary, use BACK of this sheet)

Correspondence regarding this well should be addressed to J.W. SULLIVAN & FARMER, INC. HASKELL, KANSAS


STATE OF _____, COUNTY OF _____, ss. _____ (employee of owner) or (owner or operator) of the above-described well, being first duly sworn on oath, says: That I have knowledge of the facts, statements, and matters herein contained and the log of the above-described well as filed and that the same are true and correct. So help me God.

(Signature) John O. Farmer

Russell Kans (Address)

SUBSCRIBED AND SWORN to before me this 23rd day of July, 1948, Genevieve Stricker Notary Public.

My commission expires June 14, 1952

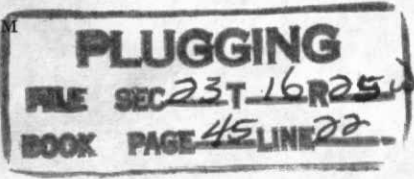

Jones, Shelburne & Farmer, Inc.

Russell, Kansas

CONTRACTOR'S VERIFIED LOG

Operator JONES, SHELBERNE & FARMER Farm Name GRASS Well No. 1
 Location HW. HW. 22 SECTION 23 - 16S - 12W
 Pool Name ARNOLD County NEOSHO State KANSAS
 Commencement Date 7/3/48 Completion Date 7/22/48

Log of Well

Depth		Formation	Deviation from Vertical (Degrees)	Remarks
From	To			
0	40	Sand & Shale		
40	214	Surface Clay		
214	265	Shale		
265	740	Shale & Lime	0°	Syfo at 500'
740	820	Sand		
820	960	Shale & Sand Streaks	0°	Syfo at 1000'
960	1655	Shale & Lime	0°	Syfo at 1500'
1655	1790	Red Rock & Shale		
1790	2065	Lime, Shale & Red Rock	0°	Syfo at 2000'
2065	2196	Anhydrite		
2196	2670	Shale & Shells	0°	Syfo at 2500'
2670	2750	Lime & Shale		
2750	2970	Lime		
2970	3960	Lime & Shale	0°	Syfo at 3000'
3960	4403	Lime	0°	Syfo at 3500'
4403	4440	Shale & Lime	0°	Syfo at 4000'
4440	4526	Lime & Shale	0°	Syfo at 4500'
4526	4568	Lime		
4568	4620	Lime & Shale Streaks		



PLUGGING
 FILE SEC 23 T 16 R 25W
 BOOK PAGE 45 LINE 22

