


WELL PLUGGING RECORD

Give All Information Completely
Make Required Affidavit
Mail or Deliver Report to:
Conservation Division
State Corporation Commission
800 Biting Building
Wichita, Kansas

Ness County, Sec. 23 Twp. 16 Rge. ~~25~~ 25 (W)

Location as "NE/CNW/SW" or footage from lines C-NW SW
Lease Owner Sohio Petroleum Company
Lease Name Holy Cross Well No. 2
Office Address Russell, Kansas
Character of Well (completed as Oil, Gas or Dry Hole) Dry
Date well completed 8-6 1953
Application for plugging filed 7-20 1953
Application for plugging approved 7-22 1953
Plugging commenced 8-3 1953
Plugging completed 8-5 1953
Reason for abandonment of well or producing formation Dry

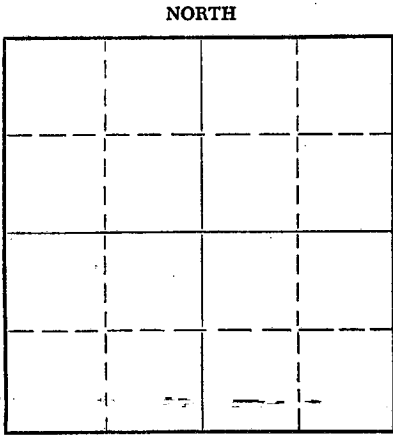

Locate well correctly on above Section Plat

If a producing well is abandoned, date of last production _____ 19____
Was permission obtained from the Conservation Division or its agents before plugging was commenced? Yes

Name of Conservation Agent who supervised plugging of this well C. D. Stough
Producing formation _____ Depth to top _____ Bottom _____ Total Depth of Well 4568 Feet
Show depth and thickness of all water, oil and gas formations.

OIL, GAS OR WATER RECORDS

CASING RECORD

FORMATION	CONTENT	FROM	TO	SIZE	PUT IN	PULLED OUT
				8-5/8"	334'	None
Lime				5-1/2"	4553'	3503'

Describe in detail the manner in which the well was plugged, indicating where the mud fluid was placed and the method or methods used in introducing it into the hole. If cement or other plugs were used, state the character of same and depth placed, from _____ feet to _____ feet for each plug set.

4568' to 310' - Heavy Mud
310' to 35' - 10' Bridge of Crushed Rock & 20 sax cement on top & Heavy mud
35' to Cellar - 10 Sax Cement

(If additional description is necessary, use BACK of this sheet)

Name of Plugging Contractor West Supply Company
Address Chase, Kansas


STATE OF KANSAS, COUNTY OF RUSSELL, ss.
J. H. BOND (employee of owner) ~~EXERCISE OF OPERATOR~~ of the above-described well, being first duly sworn on oath, says: That I have knowledge of the facts, statements, and matters herein contained and the log of the above-described well as filed and that the same are true and correct. So help me God.

(Signature) J. H. Bond
Box 678, Russell, Kansas (Address)

SUBSCRIBED AND SWORN TO before me this 10th day of August, 1953

My commission expires July 2, 1957

Russell Miller
Notary Public.

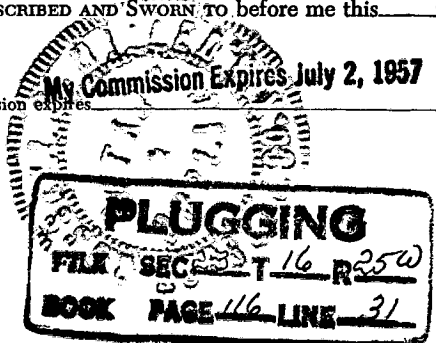

24-7366-S 3-53-20M

RECEIVED
STATE CORPORATION COMMISSION
8-11-53
AUG 11 1953
CONSERVATION DIVISION
Wichita, Kansas

SONO PETROLEUM COMPANY---HOLY CROSS # 2

Description: C- NW - SW 23-16-25 W

Elevation: 2571' (Derrick Floor)

0-120	Clay sand
300	Shale
334	Blue shale
650	Blue shale
785	Shale
860	Shale and sand
915	Sand
1324	Shale and shells
1338	Anhydrite
1930	Red rock and shale
1970	Red bed
1990	Red rock and shale
2220	Shale-shells-red bed
2335	Shale
2590	Shale and shells
2640	Shale and Lime
2795	Shale
2958	Lime and shale
2995	Red rock and shale
3060	Shale and lime
3395	Lime and shale
3595	Shale and lime
3664	Lime and shale
3944	Lime
3965	Cherty lime
4002	Lime and Chert
4123	Lime
4171	Cherty lime
4221	Lime
4278	Lime shale
4336	Shale and lime
4511	Lime and shale
4524	Lime and chert
4545	Lime

CONTRACTOR:
Mast Drilling, Inc
Russell, Kansas

TOTAL DEPTH: 4545'

Cemented 8 5/8" O. D. Casing
300' with 200 sacks Pozmix

Commenced: 5-27-53

Completed: 6-17-53

Cemented 5 1/2" O. D. at 4542 with 100
sacks of cement

STATE OF KANSAS)
COUNTY OF RUSSELL) SS

8-27-53
REGISTRATION DIVISION

I hereby certify that the above information is true and correct
to the best of my knowledge.

George P. Stoepfelwerth
MAST DRILLING, INC
By: George P. Stoepfelwerth
Vice President

Subscribed and sworn to before me this 22nd day of July, 1953

James K. Thomas
Notary Public

My Commission expires: 4/23/1954

MAST DRILLING
23-16-25W
116-31