


STATE OF KANSAS
STATE CORPORATION COMMISSION
CONSERVATION DIVISION
P. O. BOX 17027
WICHITA, KANSAS 67217

FORM CP-4

WELL PLUGGING RECORD

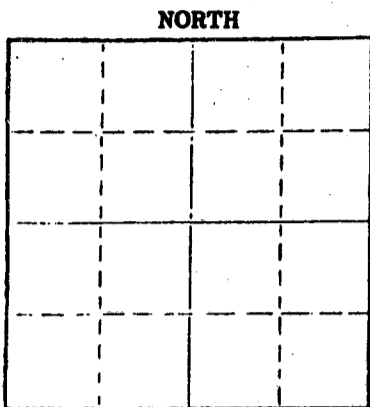

Locate well correctly on above Section Plat

Ness County. Sec. 26 Twp. 16S Rge. (E) 25 (W)
Location as "NE/CNW/SW" or footage from lines C NW NE
Lease Owner PATRICK PETROLEUM CORPORATION
Lease Name Giess 'B' Well No. 1
Office Address 200 E. First, Suite 414, Wichita, Kansas
Character of Well (completed as Oil, Gas or Dry Hole) Dry Hole
Date well completed 1-1 19 76
Application for plugging filed 1-1 19 76
Application for plugging approved 1-1 19 76
Plugging commenced 1-1 19 76
Plugging completed 1-1 19 76
Reason for abandonment of well or producing formation No commercial quantities of oil or gas encountered
If a producing well is abandoned, date of last production 19
Was permission obtained from the Conservation Division or its agents before plugging was commenced? Yes

Name of Conservation Agent who supervised plugging of this well Leo Massey
Producing formation _____ Depth to top _____ Bottom _____ Total Depth of Well 4580 Feet
Show depth and thickness of all water, oil and gas formations.

OIL, GAS OR WATER RECORDS				CASING RECORD		
FORMATION	CONTENT	FROM	TO	SIZE	PUT IN	PULLED OUT
Surface Hole	Water	Sur.	317	8-5/8"	309'	None

Describe in detail the manner in which the well was plugged, indicating where the mud fluid was placed and the method or methods used in introducing it into the hole. If cement or other plugs were used, state the character of same and depth placed, from _____ feet to _____ feet for each plug set.

Fluid to 720', plug, 70 sx cement;
Fluid to 240', plug, 20 sx cement;
Fluid to 40', plug, 10 sx cement.

Name of Plugging Contractor **D N B DRILLING, INC.**
Address 701 First National Building
Wichita, Kansas 67202

STATE OF KANSAS COUNTY OF _____ ss.
JAMES L. DONELSON (employee of owner) or (owner or operator) of the above-described

well, being first duly sworn on oath, says: That I have knowledge of the facts, statements, and matters herein contained and the log of the above-described well as filed and that the same are true and correct. So help me God.

(Signature) *James L. Donelson*
701 First Nat'l Bldg., Wichita, Kansas
(Address)

Subscribed and Sworn to before me this 9th day of January 19 76.

My commission expires 8-25-76
Ella Priess Notary Public.

RECEIVED
STATE CORPORATION COMMISSION
JAN 12 1976
CONSERVATION DIVISION
Wichita, Kansas

Ella Priess
STATE NOTARY PUBLIC
Sedgwick County, Kansas
My Com. Expires Aug. 25, 1976

15-135-21132-00-00

DRILLERS' LOG

PATRICK PETROLEUM CORPORATION

No. 1 Geiss 'B'

C NW NE, Sec. 26-16S-25W

Ness County, Kansas

Elev: 2558 K.B.

Commenced: 12-21-75

Completed: 1-1-76

Surface Casing: 309' of
8-5/8" cemented w/200 sx
common cement, 2% Gel, 3% cc.
12-21-75

FORMATION

DEPTH

Surface Hole	0 - 317
Sand & Shale	317 - 567
Shale	567 - 1330
Shale, Sand & Red Bed	1330 - 1922
Anhydrite	1922 - 1958
Red Bed & Shale	1958 - 2135
Shale	2135 - 2180
Shale & Lime	2180 - 2740
Lime & Shale	2740 - 2970
Lime	2970 - 3070
Lime & Shale	3070 - 3970
Lime	3970 - 4580 RTD

I do hereby certify that the foregoing statements are true and correct to the best of my knowledge and belief.

D N B DRILLING, INC.

James L. Donelson
JAMES L. DONELSON

STATE OF KANSAS: ss:

Subscribed and sworn to before me this 9th day of January, 1976.

Ella Priess

Ella Priess, Notary Public

Ella Priess
 STATE NOTARY PUBLIC
 Sedgwick County, Kansas
 My Com. Expires Aug. 25, 1976